



City of Prince George History Sheet

| | |
|------|-----------|
| PID: | 030301319 |
| SD: | 100461 |
| WO: | |

Civic Address: 6331 Rita Pl

Legal Description: Lot: 3 District Lot: 4028 Plan: EPP68896


| Service Type | Diameter (mm) | Material | Invert Elev at main (m) | Invert Elev at property line (m) | Invert Depth at service end (m) | Distance into property (m) | Installation Date |
|--------------|---------------|----------|-------------------------|----------------------------------|---------------------------------|----------------------------|-------------------|
| Sanitary | 100mm | PVC | 729.31 | 729.45 | 2.47 | 1.52 | July 2015 |
| Water | 20mm | Copper | 723.22 | 729.47 | 2.51 | 1.52 | July 2015 |
| Storm | 100mm | PVC | 729.26 | 729.46 | 2.45 | 3.00 | July 2015 |

| Service Connection Location | | | | Sanitary (m) | Storm (m) |
|---------------------------------|------|-------------------------|------|--------------|-----------|
| Distance from downstream San MH | 5427 | towards upstream San MH | 5428 | 48.97 | |
| Distance from downstream Stm MH | 6976 | towards upstream Stm MH | 4022 | | 51.09 |

| Power | Size | Communications | Size | Cable | Size | Gas | Size |
|---------------------|-----------|---------------------|----------|---------------------|----------|----------|--------------|
| BC Hydro | 75mm DB2+ | Telus | 50mm DB2 | Shaw | 50mm DB2 | FortisBC | 42 PROP/P.E. |
| Underground Service | | Underground Service | | Underground Service | | | |

| | | | |
|---------------|-----------------------------|--------------|---|
| Installed by: | Mike Simms | Survey Date: | - |
| Comments: | Service locate done in 2018 | | |
| | | | |
| | | | |

NOT TO SCALE The information contained herein is for internal use only.
Not to be relied on unless confirmed by site inspection and/or investigation.

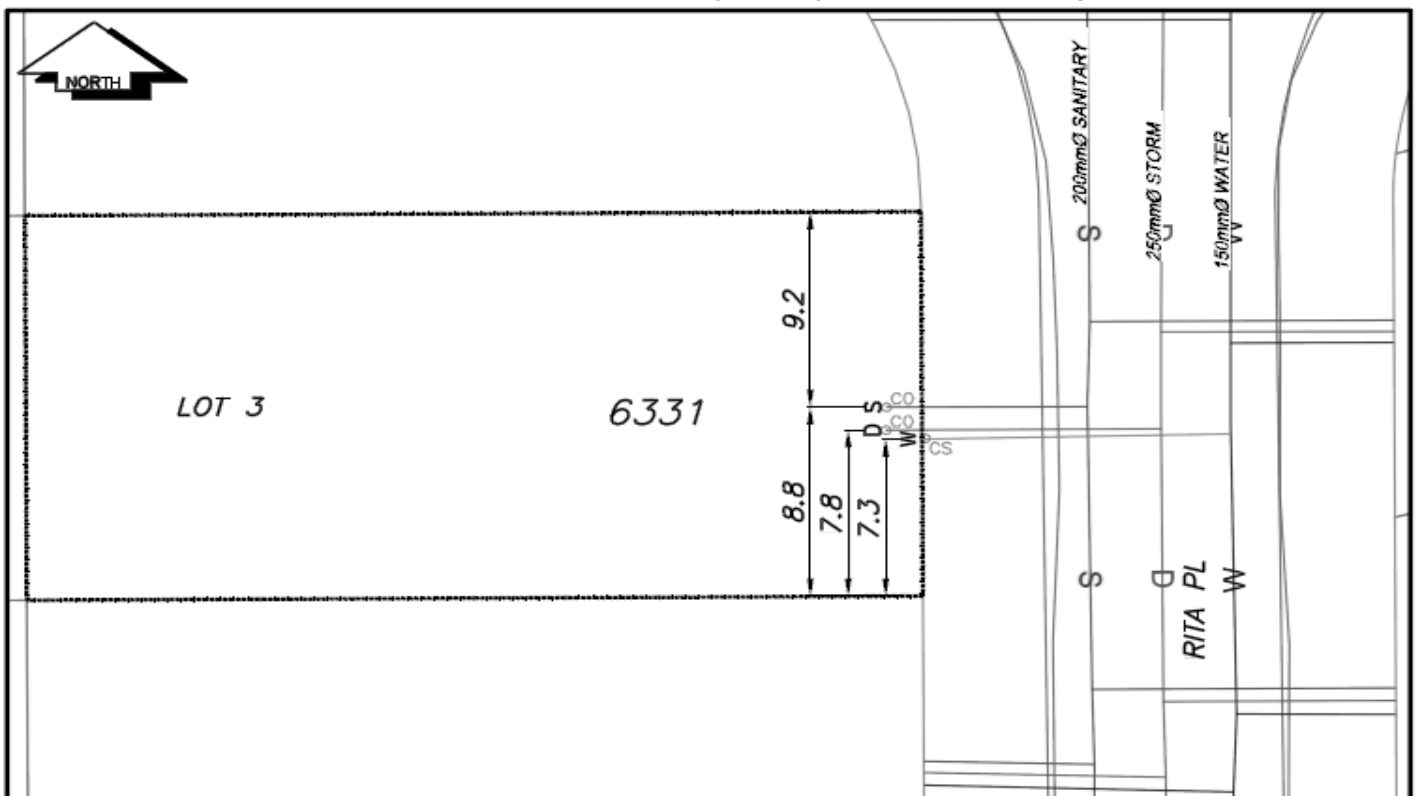

| | | |
|---------------------------|------------------------|---------------------|
| CS ^o CURB STOP | — W — WATER SERVICE | — S — STORM SERVICE |
| CO ^o CLEAN OUT | — S — SANITARY SERVICE | — G — GAS |
| ⊗ WATER VALVE | ⊗ FIRE HYDRANT | — — — ENCUMBRANCE |

NOT TO SCALE