

City of Prince George HISTORY SHEET

PID:	030-301-351
SD/MU:	SD100461
WO:	

CIVIC ADDRESS: 6378 RITA PLACE

LEGAL DESCRIPTION: LOT 7 DISTRICT LOT 4028 PLAN EPP68896


CO_{● CLEAN OUT}

SERVICE TYPE	DIAMETER (mm)	MATERIAL	INVERT ELEV AT MAIN (m)	INVERT ELEV AT PROPERTY LINE (m)	INVERT ELEV AT SERVICE END (m)	COVER AT PROPERTY LINE (m)	DISTANCE INTO PROPERTY (m)	INSTALLATION DATE
SANITARY	100	PVC	728.95	729.76	729.84	2.67	3.00	JULY 2015
WATER	19	COPPER	729.48	729.76	729.80	2.75	3.00	JULY 2015
STORM	100	PVC	729.31	729.75	729.83	2.68	3.00	JULY 2015

ELECTRICAL / COMMUNICATIONS / GAS							
TYPE	PROVIDER	SIZE AND MATERIAL	LOCATION (UNDERGROUND/ OVERHEAD)				
ELECTRICAL	BC HYDRO	75mm DB2	UNDERGROUND				
COMMUNICATION	TELUS	50mm DB2	UNDERGROUND				
COMMUNICATION	SHAW	50mm DB2	UNDERGROUND				
GAS	FORTISBC	42 PROP/P.E.	UNDERGROUND				

INFORMATION SHEETS: L&M ENGINEERING LIMITED PROJECT NUMBER 1515-01	SURVEY DATE:	JULY 2015
INSTALLED BY: MIKE SIMMS		
COMMENTS: SANITARY, STORM AND WATER MAIN WERE INSTALLED IN 1997		

THE INFORMATION CONTAINED HEREIN IS FOR INTERNAL USE ONLY. NOT TO BE RELIED UPON UNLESS CONFIRMED BY SITE INVESTIGATION.

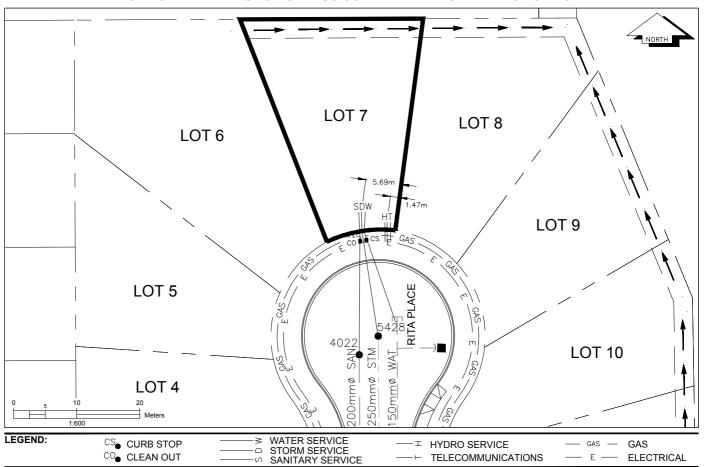

—⊢ TELECOMMUNICATIONS

— E — ELECTRICAL