



City of Prince George
History Sheet

PID:	030339456
SD/MU:	
WO:	

Civic Address:

7370 Boundary Avenue

Legal Description:

Lot 2, District Lot 748, Cariboo District, Plan EPP67262


Service Type	Diameter (mm)	Material	Invert Elev at main (m)	Invert Elev at property line (m)	Invert Elev at service end (m)	Distance into property (m)	Installation Date
Sanitary	150mm	PVC	666.75	666.80	666.82	2.93	2015
Water	150mm	PVC	665.59	665.59	665.59	2.65	2015
Storm	250mm	PVC	666.16	666.27	666.30	2.97	2015

Service Connection Location				Sanitary (m)	Storm (m)
Distance from downstream San MH		5443	towards upstream San MH	5443	0.00
Distance from downstream Stm MH		4045	towards upstream Stm MH	4045	0.00

Power	Size	Communications	Size	Cable	Size	Gas	Size
BC Hydro	3x75mm DB2	Telus	1x100mm DB2	Shaw	2x100mm DB2	FortisBC	TBD
Underground Service		Underground Service		Underground Service			

Installed by:	Teare Creek Contracting	Survey Date:	-
Comments:			

NOT TO SCALE The information contained herein is for internal use only.
Not to be relied on unless confirmed by site inspection and/or investigation.

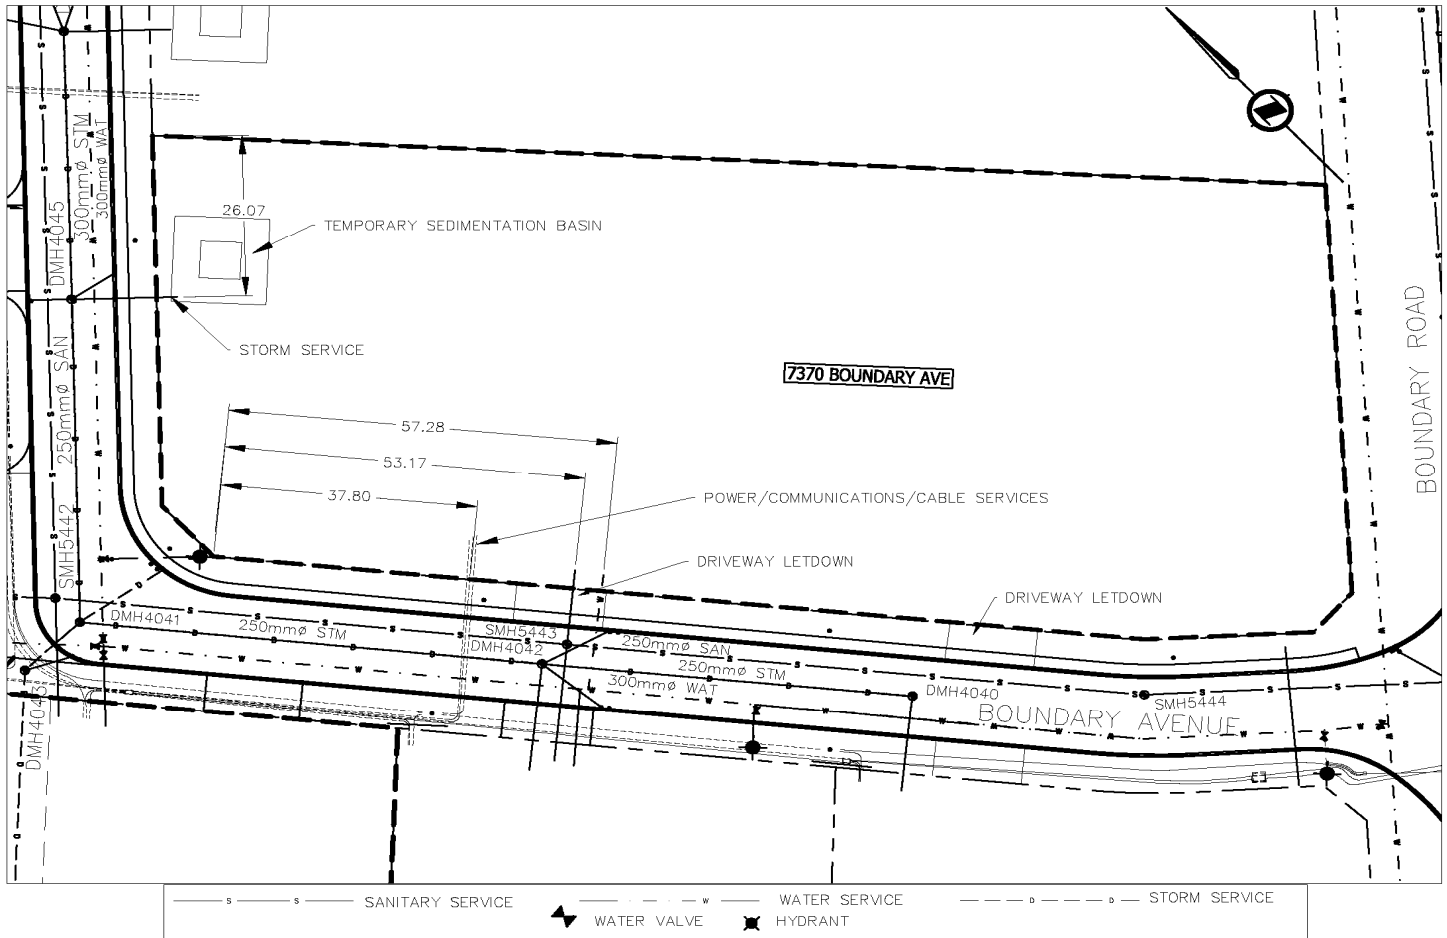

NOT TO SCALE