



City of Prince George  
**History Sheet**

PID:	030339499
SD/MU:	
WO:	

Civic Address: 7337 Boundary Avenue  
Legal Description: Lot 6, District Lot 748, Cariboo District, Plan EPP67262


Service Type	Diameter (mm)	Material	Invert Elev at main (m)	Invert Elev at property line (m)	Invert Elev at service end (m)	Distance into property (m)	Installation Date
Sanitary	200mm	PVC	666.96	666.99	667.00	2.87	2015
Water	150mm	PVC	665.22	665.36	665.38	2.24	2015
Storm SW	450mm	PVC	663.65	No Crossing	663.78	8.50	2016
Storm W	525mm	PVC	662.95	No Crossing	663.08	11.50	2016

Service Connection Location					Sanitary (m)	Storm (m)
Distance from downstream San MH	5442	towards upstream San MH	5442		0.00	
Distance from downstream Stm MH SW	4036	towards upstream Stm MH SW	4036			0.00
Distance from downstream Stm OUTFALL W	4035	towards upstream Stm MH W	4035			0.00

Power	Size	Communications	Size	Cable	Size	Gas	Size
BC Hydro	3x75mm DB2	Telus	1x100mm DB2	Shaw	2x100mm DB2	FortisBC	-
Underground Service		Underground Service		Underground Service			

Installed by:	Teare Creek Contracting	Survey Date:	-
Comments:			

**NOT TO SCALE** The information contained herein is for internal use only.  
**Not to be relied on unless confirmed by site inspection and/or investigation.**

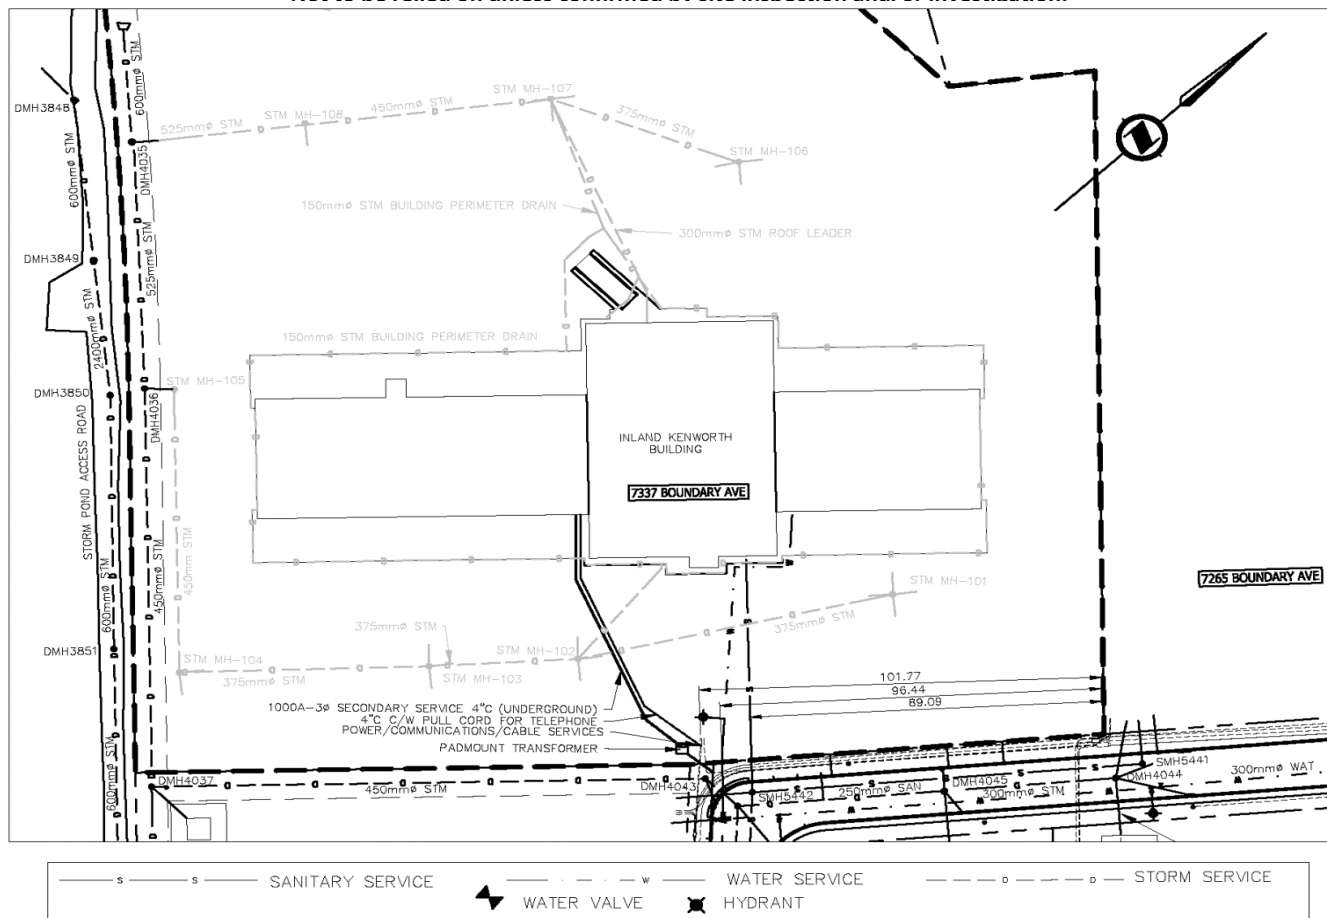

**NOT TO SCALE**