



City of Prince George History Sheet

PID:	030339502
SD/MU:	
WO:	

Civic Address: 7265 Boundary Avenue
Legal Description: Lot 7, District Lot 748, Cariboo District, Plan EPP67262


Service Type	Diameter (mm)	Material	Invert Elev at main (m)	Invert Elev at property line (m)	Invert Elev at service end (m)	Distance into property (m)	Installation Date
Sanitary	150mm	PVC	667.25	667.35	667.38	3.00	2015
Water	150mm	PVC	6665.79	665.97	666.02	4.20	2015
Storm	250mm	PVC	666.31	666.44	666.48	3.16	2015

Service Connection Location				Sanitary (m)	Storm (m)
Distance from downstream San MH	5441	towards upstream San MH	5441	0.00	
Distance from downstream Stm MH	4044	towards upstream Stm MH	4044		0.00

Power	Size	Communications	Size	Cable	Size	Gas	Size
BC Hydro	3x75mm DB2	Telus	1x100mm DB2	Shaw	2x100mm DB2	FortisBC	TBD
Underground Service		Underground Service		Underground Service			

Installed by:	Teare Creek Contracting	Survey Date:	-
Comments:			

NOT TO SCALE The information contained herein is for internal use only.
Not to be relied on unless confirmed by site inspection and/or investigation.

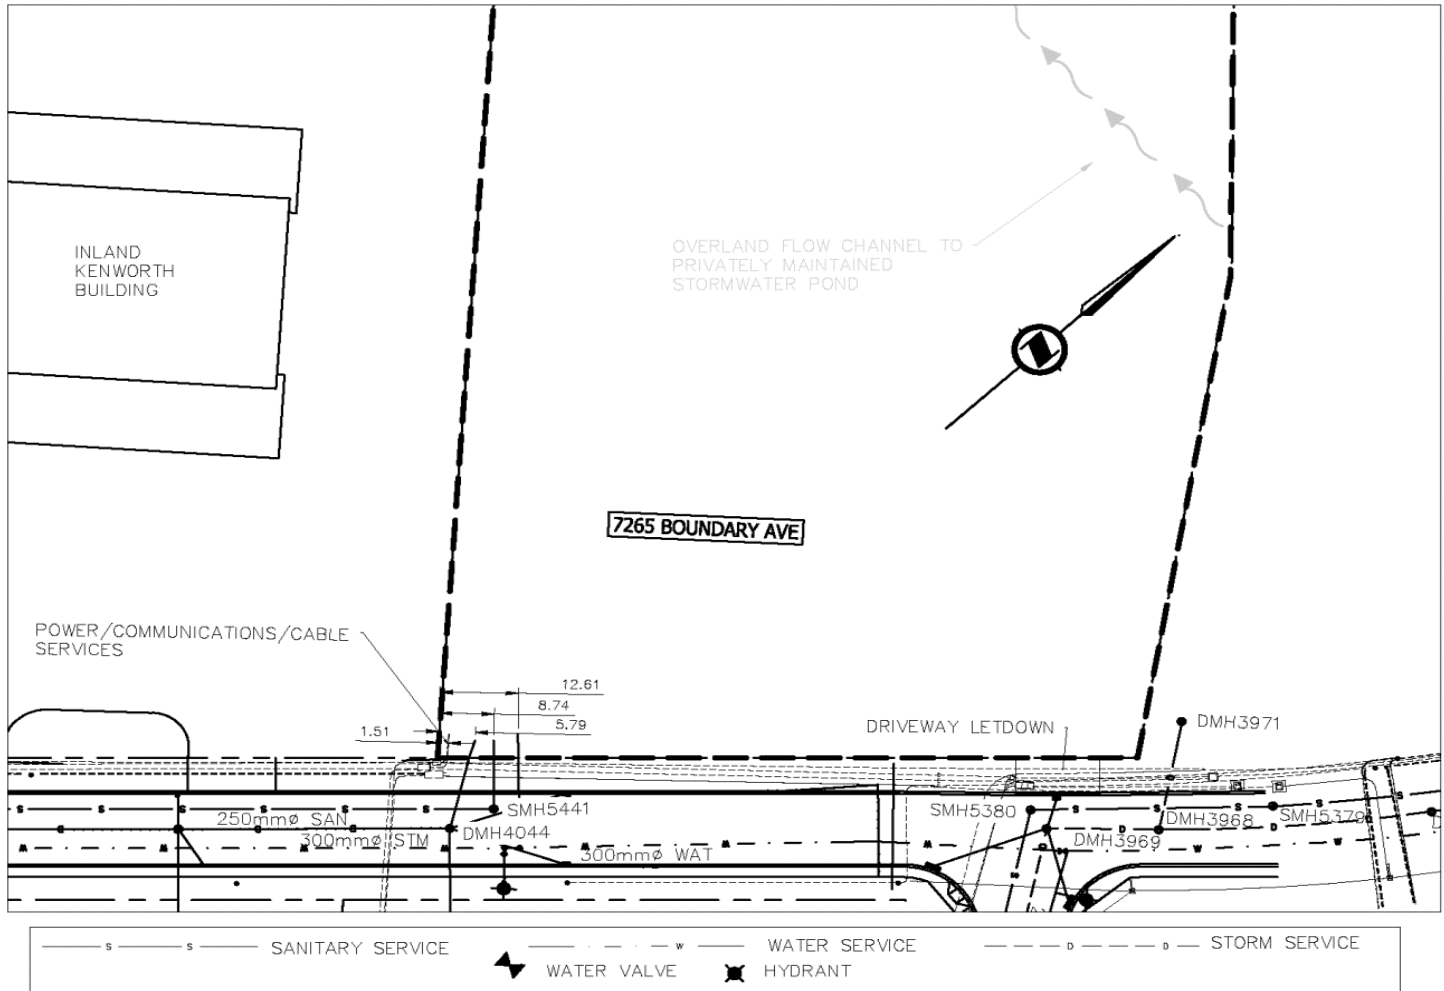

NOT TO SCALE