



CITY OF
PRINCE GEORGE

City of Prince George HISTORY SHEET

| | |
|--------|-------------|
| PID: | 030-361-346 |
| SD/MU: | SD100460 |
| WO: | |

CIVIC ADDRESS: 2759 LINKS DRIVE

LEGAL DESCRIPTION: LOT 4 DISTRICT LOT 7645 PLAN EPP74488

| SERVICE TYPE | DIAMETER (mm) | MATERIAL | INVERT ELEV AT MAIN (m) | INVERT ELEV AT PROPERTY LINE (m) | INVERT ELEV AT SERVICE END (m) | COVER AT PROPERTY LINE (m) | DISTANCE INTO PROPERTY (m) | INSTALLATION DATE |
|--------------|---------------|----------|-------------------------|----------------------------------|--------------------------------|----------------------------|----------------------------|-------------------|
| SANITARY | 100 | PCV | 652.53 | 652.87 | 652.97 | 2.18 | 3.00 | AUGUST 2017 |
| WATER | 19 | COPPER | 652.06 | 652.79 | 652.89 | 2.36 | 3.00 | AUGUST 2017 |
| STORM | 100 | PVC | 652.53 | 652.95 | 653.02 | 2.11 | 3.00 | AUGUST 2017 |

ELECTRICAL / COMMUNICATIONS / GAS

| TYPE | PROVIDER | SIZE AND MATERIAL | LOCATION (UNDERGROUND/ OVERHEAD) |
|---------------|----------|-------------------|-----------------------------------|
| ELECTRICAL | BC HYDRO | 75mm DB2 | UNDERGROUND |
| COMMUNICATION | TELUS | 50mm DB2 | UNDERGROUND |
| COMMUNICATION | SHAW | 50mm DB2 | UNDERGROUND |
| GAS | FORTISBC | 42 PROP/P.E. | UNDERGROUND |


INFORMATION SHEETS: L&M ENGINEERING LIMITED PROJECT NUMBER 1253-05

SURVEY DATE: AUGUST 2017

INSTALLED BY: ABERDEEN GLEN DEVELOPMENTS

COMMENTS:

THE INFORMATION CONTAINED HEREIN IS FOR INTERNAL USE ONLY.
NOT TO BE RELIED UPON UNLESS CONFIRMED BY SITE INVESTIGATION.

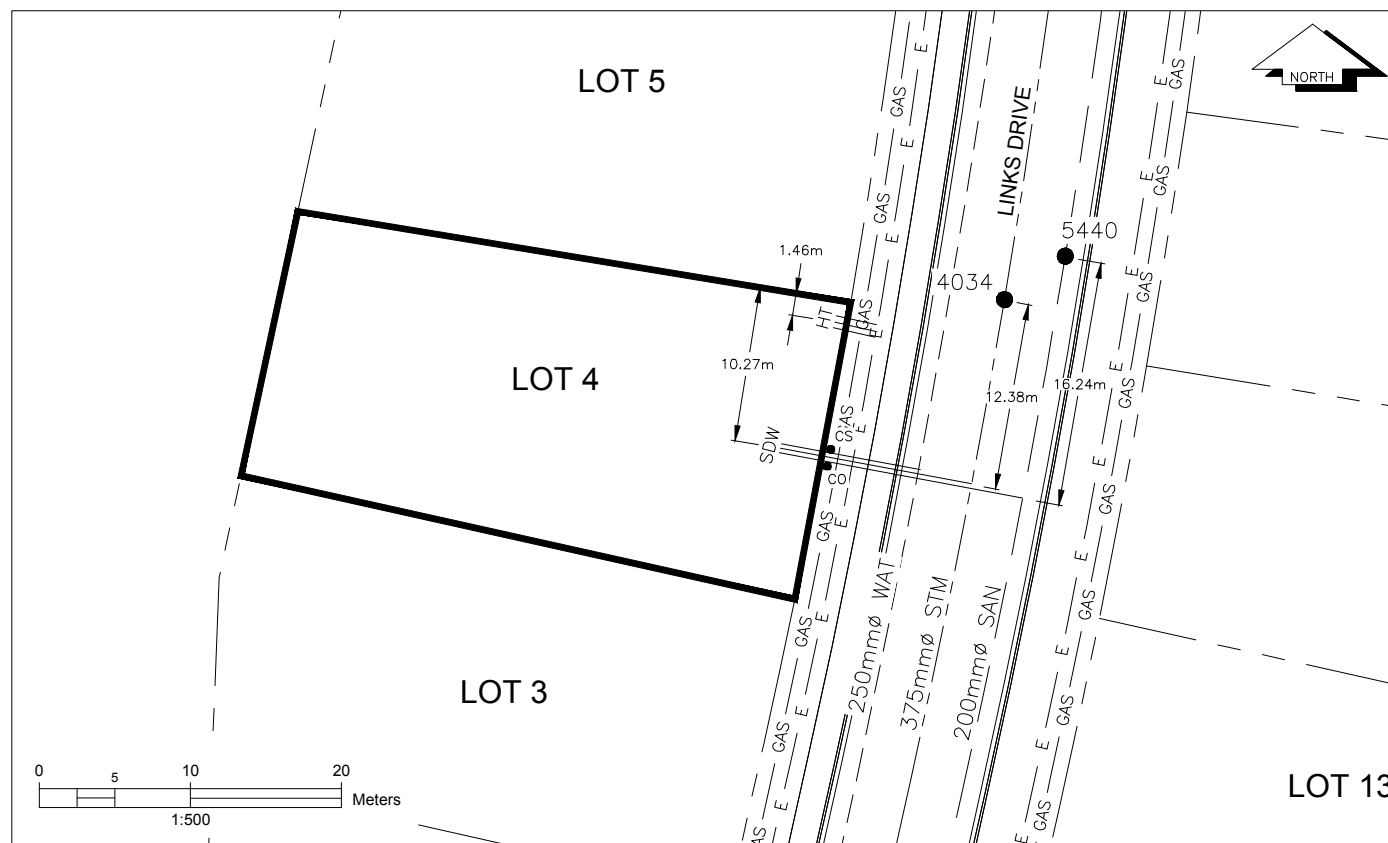

LEGEND:

CS CURB STOP

CO CLEAN OUT

W W

S D W

WATER SERVICE

STORM SERVICE

SANITARY SERVICE

H HYDRO SERVICE

T TELECOMMUNICATIONS

GAS GAS

E ELECTRICAL