



CITY OF  
PRINCE GEORGE

## City of Prince George HISTORY SHEET

PID:	030-361-401
SD/MU:	SD100460
WO:	

CIVIC ADDRESS: 2802 LINKS DRIVE


LEGAL DESCRIPTION: LOT 10 DISTRICT LOT 7645 PLAN EPP74488

SERVICE TYPE	DIAMETER (mm)	MATERIAL	INVERT ELEV AT MAIN (m)	INVERT ELEV AT PROPERTY LINE (m)	INVERT ELEV AT SERVICE END (m)	COVER AT PROPERTY LINE (m)	DISTANCE INTO PROPERTY (m)	INSTALLATION DATE
SANITARY	100	PVC	652.88	653.24	653.33	2.17	3.00	AUGUST 2017
WATER	19	COPPER	652.45	653.18	653.22	2.32	3.00	AUGUST 2017
STORM	100	PVC	652.87	653.26	653.32	2.16	3.00	AUGUST 2017

ELECTRICAL / COMMUNICATIONS / GAS			
TYPE	PROVIDER	SIZE AND MATERIAL	LOCATION ( UNDERGROUND/ OVERHEAD)
ELECTRICAL	BC HYDRO	75mm DB2	UNDERGROUND
COMMUNICATION	TELUS	50mm DB2	UNDERGROUND
COMMUNICATION	SHAW	50mm DB2	UNDERGROUND
GAS	FORTISBC	42 PROP/P.E.	UNDERGROUND

INFORMATION SHEETS: L&M ENGINEERING LIMITED PROJECT NUMBER 1253-05	SURVEY DATE: AUGUST 2017
INSTALLED BY: ABERDEEN GLEN DEVELOPMENTS	
COMMENTS:	

THE INFORMATION CONTAINED HEREIN IS FOR INTERNAL USE ONLY.  
NOT TO BE RELIED UPON UNLESS CONFIRMED BY SITE INVESTIGATION.

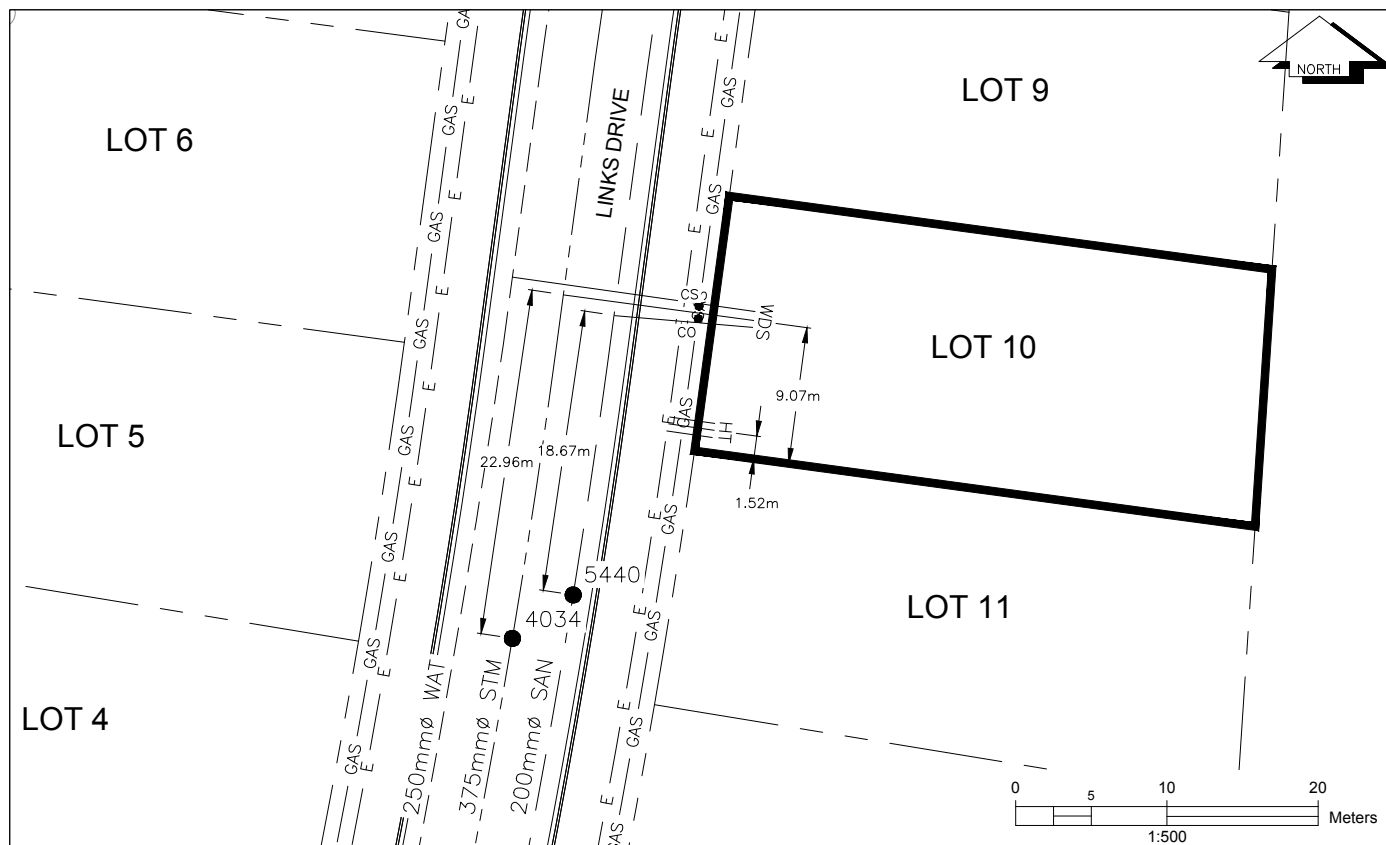

LEGEND:			
CS ● CURB STOP	W WATER SERVICE	— H HYDRO SERVICE	— GAS — GAS
CO ● CLEAN OUT	SD STORM SERVICE	— T TELECOMMUNICATIONS	— E — ELECTRICAL
	S SANITARY SERVICE		