



CITY OF
PRINCE GEORGE

City of Prince George HISTORY SHEET

PID:	030-361-460
SD/MU:	SD100460
WO:	

CIVIC ADDRESS: 2706 LINKS DRIVE

LEGAL DESCRIPTION: LOT 16 DISTRICT LOT 4377 & 7645 PLAN EPP74488

SERVICE TYPE	DIAMETER (mm)	MATERIAL	INVERT ELEV AT MAIN (m)	INVERT ELEV AT PROPERTY LINE (m)	INVERT ELEV AT SERVICE END (m)	COVER AT PROPERTY LINE (m)	DISTANCE INTO PROPERTY (m)	INSTALLATION DATE
SANITARY	100	PVC	651.70	652.14	652.24	2.10	3.00	AUGUST 2017
WATER	19	COPPER	651.10	652.08	652.25	2.25	3.00	AUGUST 2017
STORM	100	PVC	651.86	652.18	652.23	2.07	3.00	AUGUST 2017

ELECTRICAL / COMMUNICATIONS / GAS

TYPE	PROVIDER	SIZE AND MATERIAL	LOCATION (UNDERGROUND/ OVERHEAD)
ELECTRICAL	BC HYDRO	75mm DB2	UNDERGROUND
COMMUNICATION	TELUS	50mm DB2	UNDERGROUND
COMMUNICATION	SHAW	50mm DB2	UNDERGROUND
GAS	FORTISBC	42 PROP/P.E.	UNDERGROUND


INFORMATION SHEETS: L&M ENGINEERING LIMITED PROJECT NUMBER 1253-05

SURVEY DATE: AUGUST 2017

INSTALLED BY: ABERDEEN GLEN DEVELOPMENTS

COMMENTS:

THE INFORMATION CONTAINED HEREIN IS FOR INTERNAL USE ONLY.
NOT TO BE RELIED UPON UNLESS CONFIRMED BY SITE INVESTIGATION.

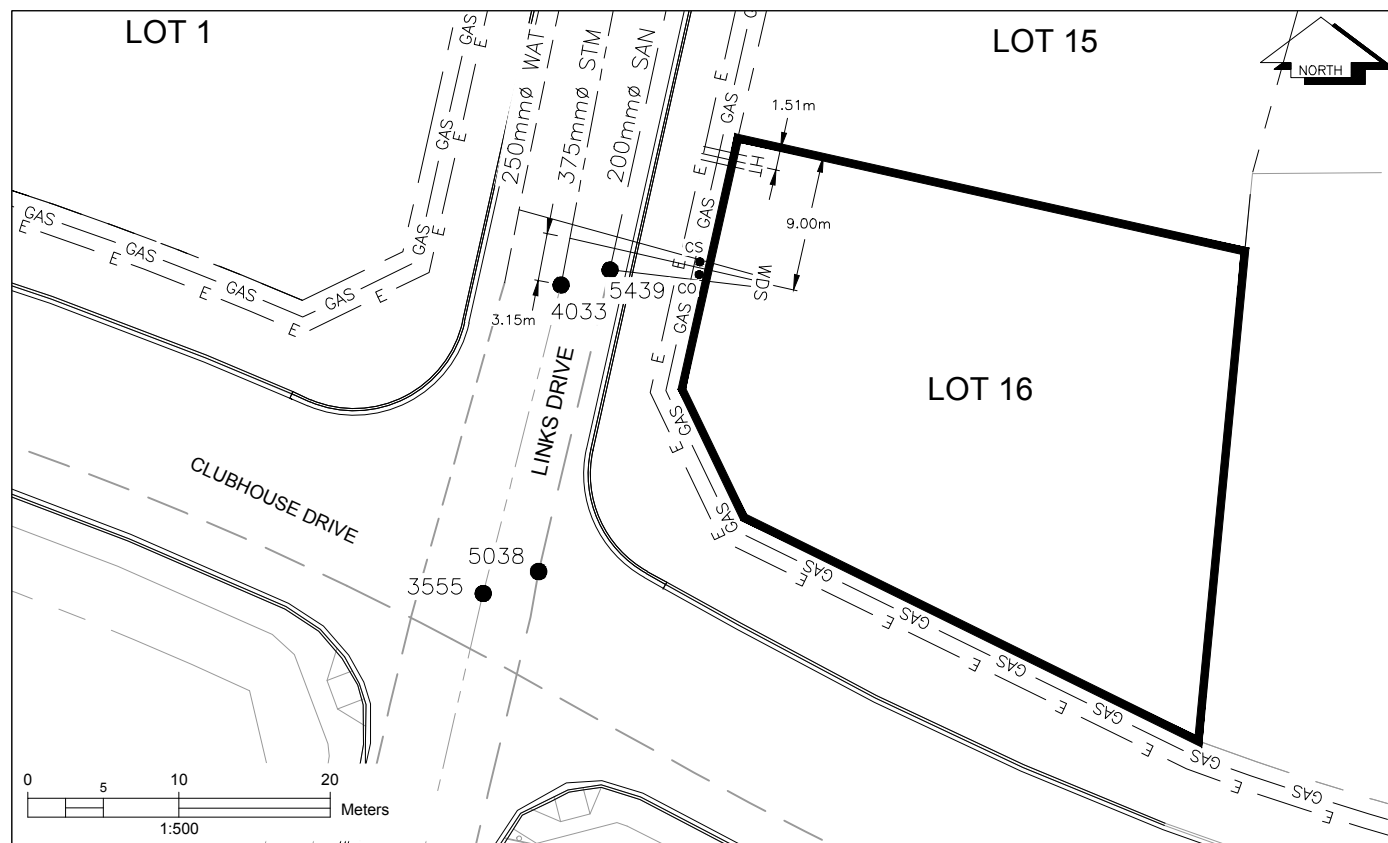

LEGEND:

CS CURB STOP
CO CLEAN OUT

W WATER SERVICE
S D W STORM SERVICE
S SANITARY SERVICE

HYDRO SERVICE
TELECOMMUNICATIONS

GAS GAS
E ELECTRICAL