



CITY OF
PRINCE GEORGE

City of Prince George HISTORY SHEET

| | |
|--------|-------------|
| PID: | 030-377-960 |
| SD/MU: | SD100494 |
| WO: | |

CIVIC ADDRESS: 2481 CARMICHAEL STREET

LEGAL DESCRIPTION: LOT 1 DISTRICT LOT 1600 PLAN EPP72860

| SERVICE TYPE | DIAMETER (mm) | MATERIAL | INVERT ELEV AT MAIN (m) | INVERT ELEV AT PROPERTY LINE (m) | INVERT ELEV AT SERVICE END (m) | COVER AT PROPERTY LINE (m) | DISTANCE INTO PROPERTY (m) | INSTALLATION DATE |
|--------------|---------------|----------|-------------------------|----------------------------------|--------------------------------|----------------------------|----------------------------|-------------------|
| SANITARY | 100 | PVC | 722.19 | 723.23 | 723.37 | 2.04 | 3.00 | MAY 2017 |
| WATER | 19 | COPPER | 722.57 | 723.13 | 723.22 | 2.29 | 3.00 | MAY 2017 |
| STORM | 100 | PVC | 722.81 | 723.23 | 723.31 | 2.07 | 3.00 | MAY 2017 |

ELECTRICAL / COMMUNICATIONS / GAS

| TYPE | PROVIDER | SIZE AND MATERIAL | LOCATION (UNDERGROUND/ OVERHEAD) |
|---------------|----------|-------------------|-----------------------------------|
| ELECTRICAL | BC HYDRO | 75mm DB2 | UNDERGROUND |
| COMMUNICATION | TELUS | 50mm DB2 | UNDERGROUND |
| COMMUNICATION | SHAW | 50mm DB2 | UNDERGROUND |
| GAS | FORTISBC | 42 PROP/P.E. | UNDERGROUND |


INFORMATION SHEETS: L&M ENGINEERING LIMITED PROJECT NUMBER 1273-22

SURVEY DATE: MAY 2017

INSTALLED BY: JOE ROBERTS CONSTRUCTION

COMMENTS:

THE INFORMATION CONTAINED HEREIN IS FOR INTERNAL USE ONLY.
NOT TO BE RELIED UPON UNLESS CONFIRMED BY SITE INVESTIGATION.

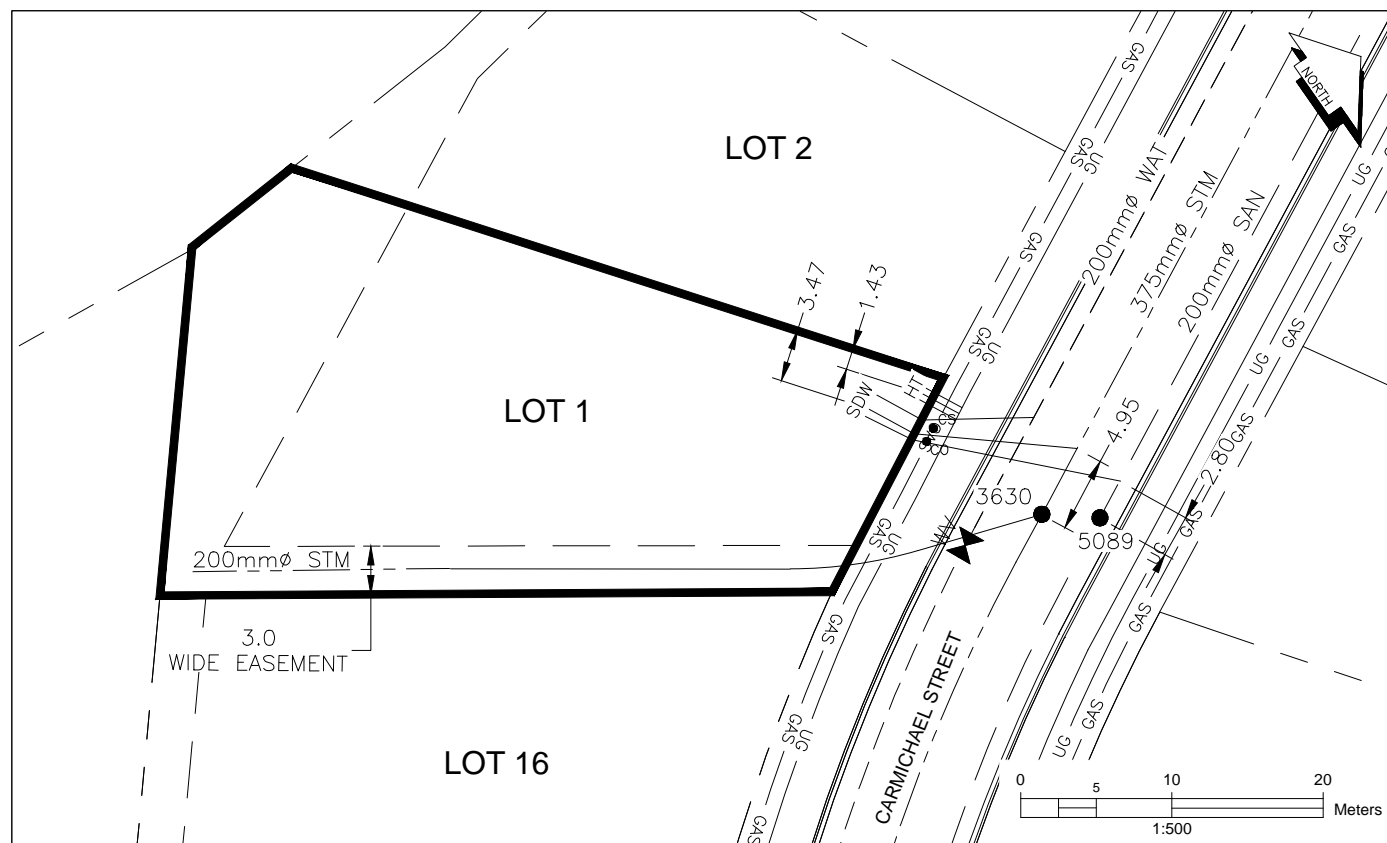

LEGEND:

| | | | | |
|----------------|-------------------------|--------------------------|------------------|-----------|
| CS ● CURB STOP | — W — WATER SERVICE | — H — HYDRO SERVICE | — G — GAS | — G — GAS |
| CO ● CLEAN OUT | — S — STORM SERVICE | — T — TELECOMMUNICATIONS | — E — ELECTRICAL | |
| | — SD — SANITARY SERVICE | | | |