

PID:	030-378-010
SD/MU:	SD100494
WO:	

CIVIC ADDRESS: 2457 CARMICHAEL STREET

LEGAL DESCRIPTION: LOT 5 DISTRICT LOT 1600 PLAN EPP72860

SERVICE TYPE	DIAMETER (mm)	MATERIAL	INVERT ELEV AT MAIN (m)	INVERT ELEV AT PROPERTY LINE (m)	INVERT ELEV AT SERVICE END (m)	COVER AT PROPERTY LINE (m)	DISTANCE INTO PROPERTY (m)	INSTALLATION DATE
SANITARY	100	PVC	725.28	725.92	726.10	2.16	3.00	MAY 2017
WATER	19	COPPER	725.09	725.93	726.04	2.27	3.00	MAY 2017
STORM	100	PVC	725.39	725.92	726.10	2.19	3.00	MAY 2017

ELECTRICAL / COMMUNICATIONS / GAS

TYPE	PROVIDER	SIZE AND MATERIAL	LOCATION (UNDERGROUND/ OVERHEAD)
ELECTRICAL	BC HYDRO	75mm DB2	UNDERGROUND
COMMUNICATION	TELUS	50mm DB2	UNDERGROUND
COMMUNICATION	SHAW	50mm DB2	UNDERGROUND
GAS	FORTISBC	42 PROP/P.E.	UNDERGROUND


INFORMATION SHEETS: L&M ENGINEERING LIMITED PROJECT NUMBER 1273-22

SURVEY DATE: MAY 2017

INSTALLED BY: JOE ROBERTS CONSTRUCTION

COMMENTS:

THE INFORMATION CONTAINED HEREIN IS FOR INTERNAL USE ONLY.
NOT TO BE RELIED UPON UNLESS CONFIRMED BY SITE INVESTIGATION.

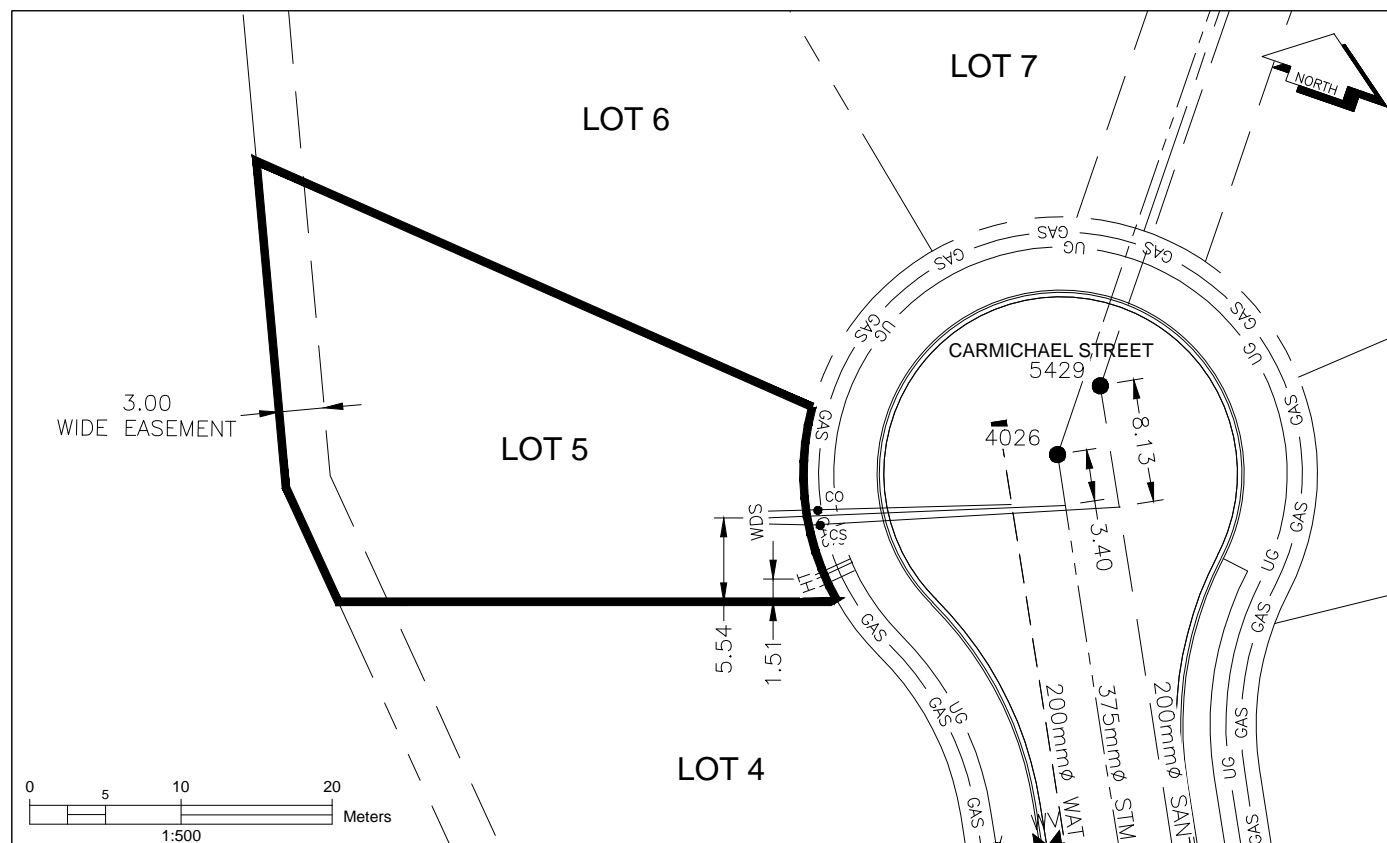

LEGEND:

CS CURB STOP

CO CLEAN OUT

_____ D
_____ S

WATER SERVICE

STORM SERVICE
SANITARY SERVI

SANITARY SERVICE

— I HYDRO SERVICE

— TELECOMMUNICATIONS

— GAS — GAS

— E — ELECTRICAL
