



CITY OF  
PRINCE GEORGE

# City of Prince George HISTORY SHEET

PID:	030-378-460
SD/MU:	SD100494
WO:	

CIVIC ADDRESS: 2454 ROWE STREET

LEGAL DESCRIPTION: LOT 29 DISTRICT LOT 2616 PLAN EPP72860

SERVICE TYPE	DIAMETER (mm)	MATERIAL	INVERT ELEV AT MAIN (m)	INVERT ELEV AT PROPERTY LINE (m)	INVERT ELEV AT SERVICE END (m)	COVER AT PROPERTY LINE (m)	DISTANCE INTO PROPERTY (m)	INSTALLATION DATE
SANITARY	100	PVC	726.85	727.47	727.48	2.72	3.00	MAY 2017
WATER	19	COPPER	726.87	727.54	727.50	2.82	3.00	MAY 2017
STORM	100	PVC	727.03	727.47	27.50	2.76	3.00	MAY 2017

## ELECTRICAL / COMMUNICATIONS / GAS

TYPE	PROVIDER	SIZE AND MATERIAL	LOCATION ( UNDERGROUND/ OVERHEAD)
ELECTRICAL	BC HYDRO	75mm DB2	UNDERGROUND
COMMUNICATION	TELUS	50mm DB2	UNDERGROUND
COMMUNICATION	SHAW	50mm DB2	UNDERGROUND
GAS	FORTISBC	42 PROP/P.E.	UNDERGROUND


INFORMATION SHEETS: L&M ENGINEERING LIMITED PROJECT NUMBER 1273-22

SURVEY DATE: MAY 2017

INSTALLED BY: JOE ROBERTS CONSTRUCTION

COMMENTS:

THE INFORMATION CONTAINED HEREIN IS FOR INTERNAL USE ONLY.  
NOT TO BE RELIED UPON UNLESS CONFIRMED BY SITE INVESTIGATION.

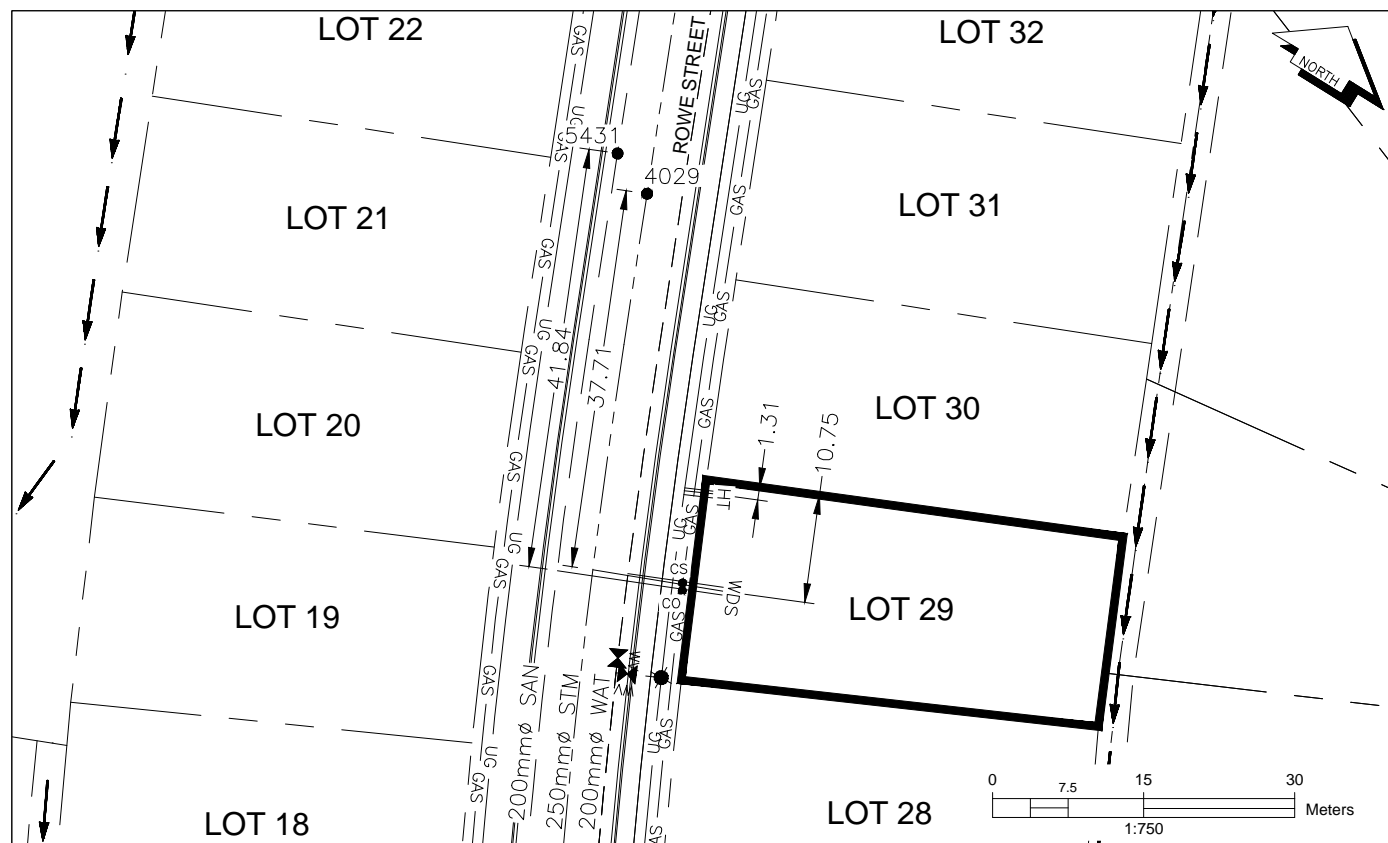

## LEGEND:

CS CURB STOP  
CO CLEAN OUT  
W WATER SERVICE  
SD STORM SERVICE  
S SANITARY SERVICE  
H HYDRO SERVICE  
T TELECOMMUNICATIONS  
GAS GAS  
E ELECTRICAL