



CIVIC ADDRESS: 2442 ROWE STREET

LEGAL DESCRIPTION: LOT 31 DISTRICT LOT 2616 PLAN EPP72860


PID:	030-378-486
SD/MU:	SD100494
WO:	

SERVICE TYPE	DIAMETER (mm)	MATERIAL	INVERT ELEV AT MAIN (m)	INVERT ELEV AT PROPERTY LINE (m)	INVERT ELEV AT SERVICE END (m)	COVER AT PROPERTY LINE (m)	DISTANCE INTO PROPERTY (m)	INSTALLATION DATE
SANITARY	100	PVC	729.44	730.21	730.28	2.27	3.00	MAY 2017
WATER	19	COPPER	729.28	730.18	730.28	2.41	3.00	MAY 2017
STORM	100	PVC	729.83	730.20	730.27	2.29	3.00	MAY 2017

ELECTRICAL / COMMUNICATIONS / GAS			
TYPE	PROVIDER	SIZE AND MATERIAL	LOCATION (UNDERGROUND/ OVERHEAD)
ELECTRICAL	BC HYDRO	75mm DB2	UNDERGROUND
COMMUNICATION	TELUS	50mm DB2	UNDERGROUND
COMMUNICATION	SHAW	50mm DB2	UNDERGROUND
GAS	FORTISBC	42 PROP/P.E.	UNDERGROUND

INFORMATION SHEETS: L&M ENGINEERING LIMITED PROJECT NUMBER 1273-22	SURVEY DATE: MAY 2017
INSTALLED BY: JOE ROBERTS CONSTRUCTION	
COMMENTS:	

THE INFORMATION CONTAINED HEREIN IS FOR INTERNAL USE ONLY.
NOT TO BE RELIED UPON UNLESS CONFIRMED BY SITE INVESTIGATION.

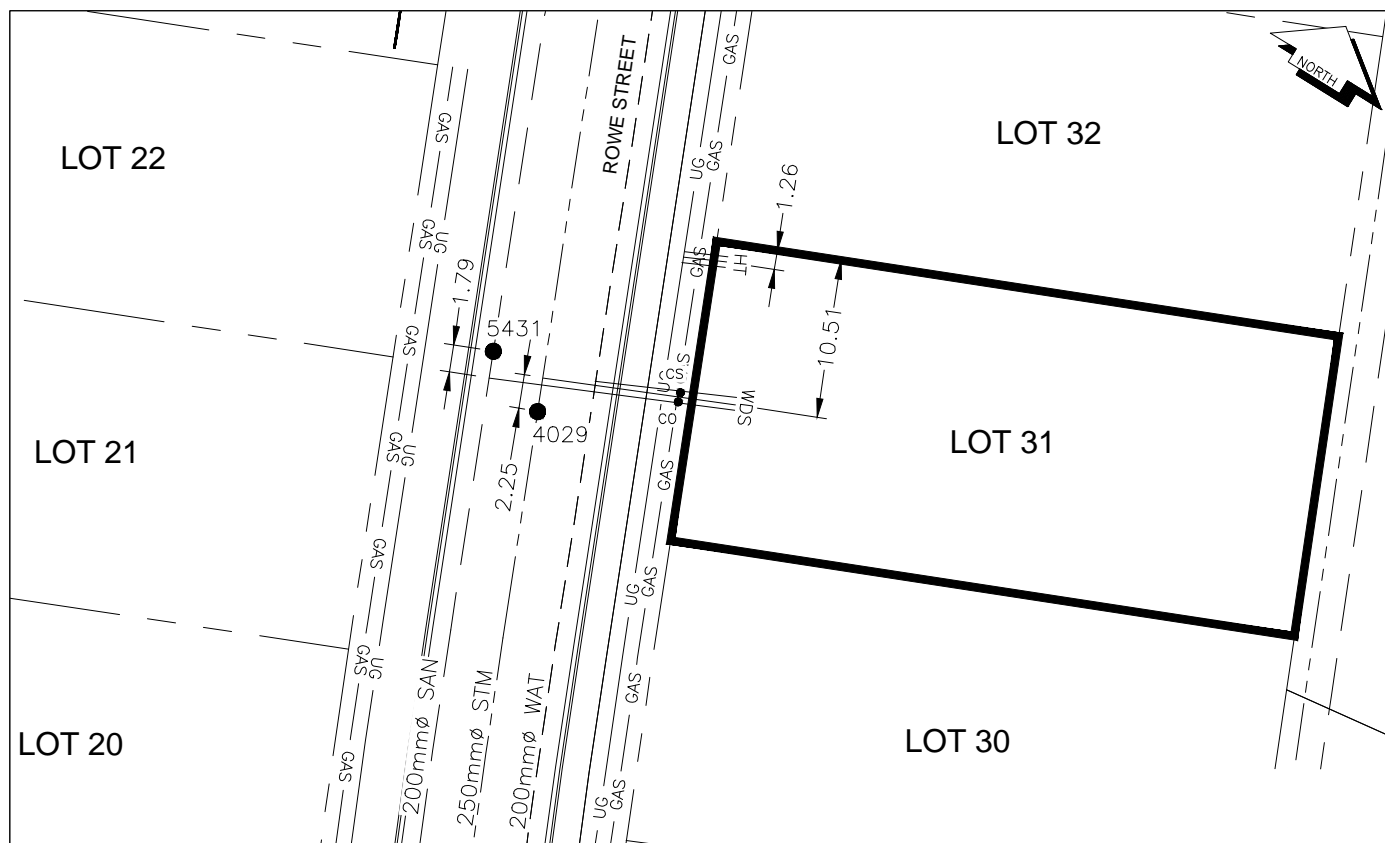

LEGEND:

- | | | | | | | | | |
|----|---|-----------|-----|------------------|-----|--------------------|-------|--------------|
| CS | ● | CURB STOP | — W | WATER SERVICE | — H | HYDRO SERVICE | — GAS | — GAS |
| CO | ● | CLEAN OUT | — S | STORM SERVICE | — T | TELECOMMUNICATIONS | — E | — ELECTRICAL |
| | | | — S | SANITARY SERVICE | | | | |