



City of Prince George
History Sheet

PID:	030387884
MU:	100111/100032
	101048/100032
WO:	

University Hospital of Northern BC (UHNBC)
Principal civic address: 1475 Edmonton St

Civic Address: 1475, 1444, 1488 Edmonton St
1230, 1308, 1350 Alward St
1111, 1215 Lethbridge St

Legal Description: Lot: A District Lot: 343 Plan: EPP61060 except Plan EPP61362

Service Type	Diameter (mm)	Material	Invert Elev at main (m)	Invert Elev at property line (m)	Invert Elev at service end (m)	Distance into property (m)	Installation Date
Sanitary (S1)	100mm	AC	-	-	-	-	January 1975
Sanitary (S2)	150mm	AC	-	-	-	-	January 1975
Sanitary (S3)	150mm	PVC	-	-	-	-	June 2010
Sanitary (S4)	Unknown	AC	-	-	-	-	January 1957
Sanitary (S5)	Unknown	AC	-	-	-	-	January 1957
Sanitary (S6)	250mm	PVC	-	-	-	-	January 1957
Sanitary (S7)	100mm	AC	-	-	-	-	December 1956
Sanitary (S8)	100mm	PVC	-	-	-	-	December 1956
Water (W1)	200mm	AC	-	-	-	-	January 1971
Water (W2)	150mm	Cast Iron	-	-	-	-	January 1957
Water (W3)	200mm	PVC	-	-	-	-	June 2010
Water (W4)	150mm	Cast Iron	-	-	-	-	December 1956
Water (W5)	Unknown	Cast Iron	-	-	-	-	December 1956
Water (W6)	25mm	Copper	-	-	-	-	December 1956
Storm (D1)	Unknown	Unknown	-	-	-	-	January 1965
Storm (D2)	250mm	PVC	-	-	-	-	June 2010
Storm (D3)	300mm	AC	-	-	-	-	January 1978
Storm (D4)	250mm	AC	-	-	-	-	January 1978
Storm (D5)	250mm	AC	-	-	-	-	December 1958
Storm (D6)	150mm	AC	-	582.25	-	-	Dec-77

Service Connection Location				Sanitary (m)	Storm (m)
Distance from downstream San MH	2837	towards upstream San MH	2842	12.13	
150mm Sanitary service connected to San MH on Lethbridge St					
150mm Sanitary service connected to San MH2835 on Lethbridge St					
Sanitary service connected to San MH2840					
Sanitary service connected to San MH2839					
Distance from downstream San MH	739	towards upstream San MH	875	128.00	
XXX Sanitary main connected to San MH739					
Distance from downstream San MH	739	towards upstream San MH	875		
Storm service connected to Stm MH 3159					
250mm Storm service connected to Stm MH 3775					
Distance from downstream Stm MH	3138	towards upstream Stm MH	3182		52.48
250mm Storm service connected to Stm MH 3182					
Distance from downstream Stm MH	2496	towards upstream Stm MH	3183		93.44
Distance from downstream Stm MH	DMH	towards upstream Stm MH	3182		55.47


qsave

Power	Size	Communications	Size	Cable	Size	Gas	Size
BC Hydro	-	Telus	-	Shaw	-	FortisBC	-
Underground Service		Underground Service		Underground Service			

Installed by:	City of Prince George forces	Survey Date:	-
Comments:			

NOT TO SCALE The information contained herein is for internal use only.
NOT TO SCALE
Not to be relied on unless confirmed by site inspection and/or investigation.

NOT TO SCALE The information contained herein is for internal use only. Not to be relied on unless confirmed by site inspection and/or investigation.

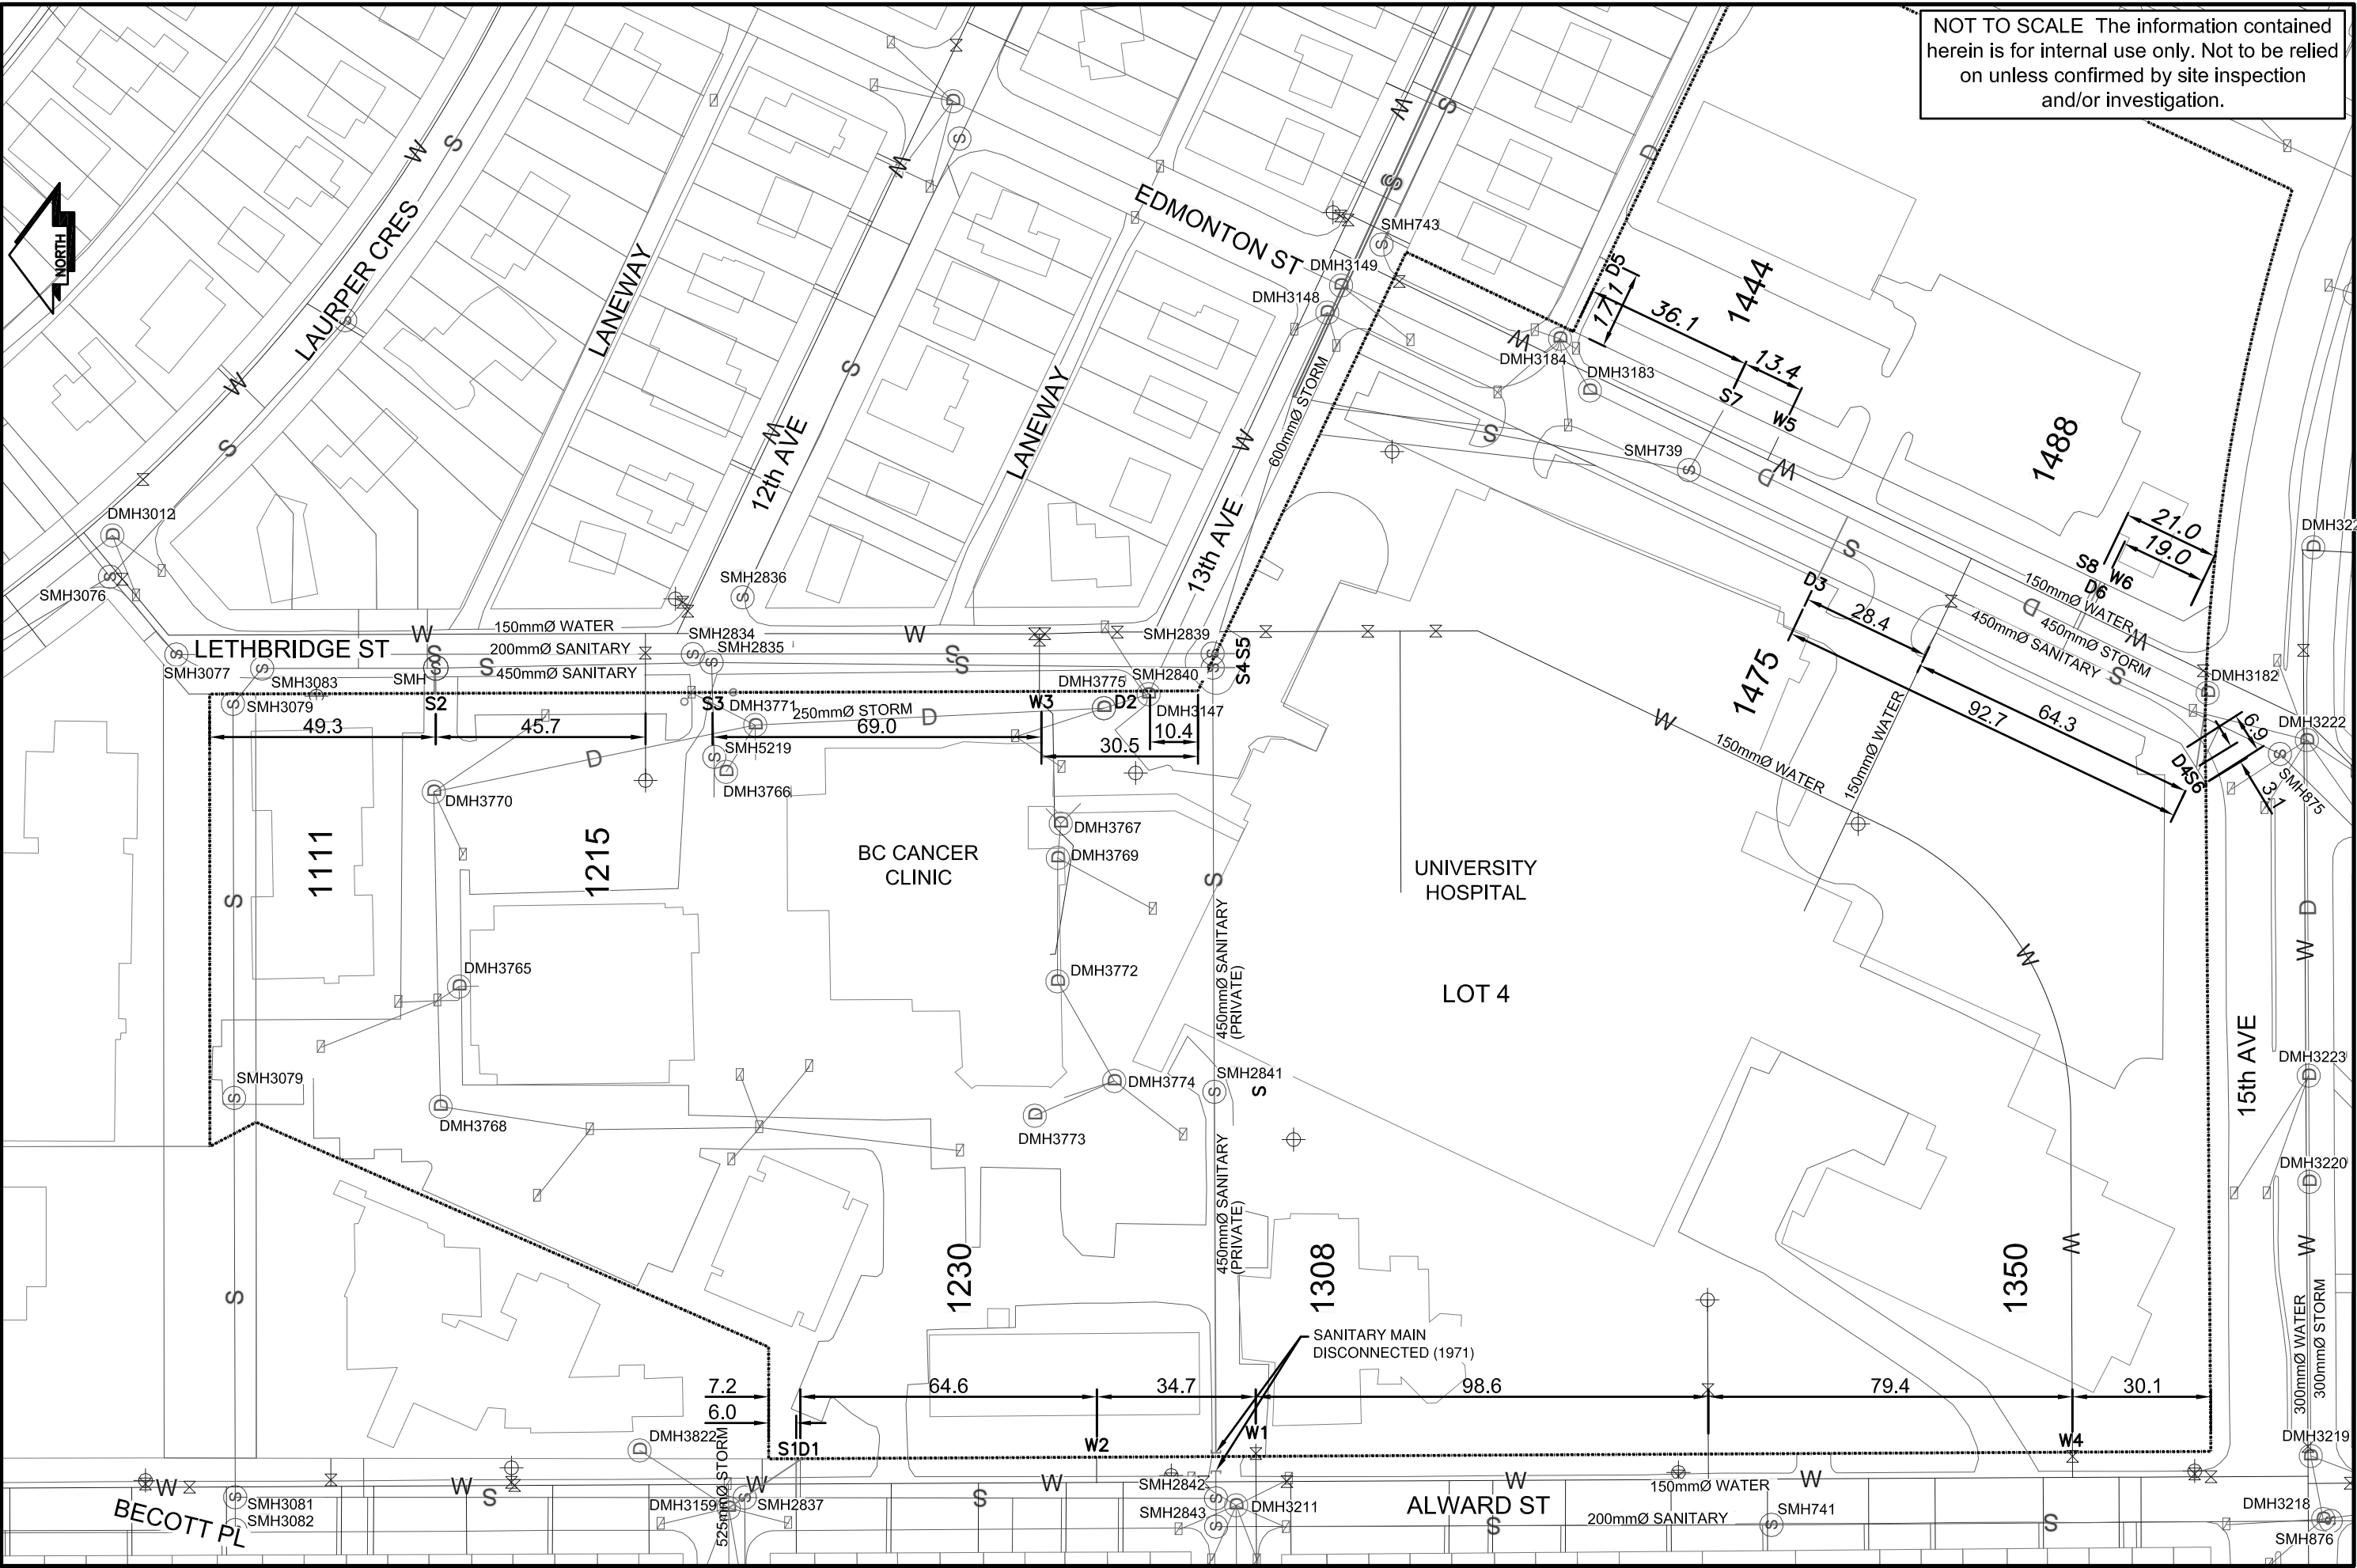

LEGEND:

CS

○

CURB STOP

CO

○

CLEAN OUT

W

—

WATER SERVICE

S

SANITARY SERVICE

D

—

STORM SERVICE

G

—

GAS