



City of Prince George History Sheet

PID:	030399793
SD/MU:	100529/101927
WO:	93231

Civic Address: 8211 Peter Rd

Legal Description: Lot: 3 District Lot: 2424 Plan: EPP77320


Service Type	Diameter (mm)	Material	Invert Elev at main (m)	Invert Elev at property line (m)	Invert Elev at service end (m)	Distance into property (m)	Installation Date
Sanitary	100mm	PVC	750.71	751.14	751.35	2.00	September 2017
Water	20mm	Copper	751.07	751.03	751.28	2.00	September 2017
Storm	N/A	N/A	-	-	-	-	

Service Connection Location				Sanitary (m)	Storm (m)
Distance from downstream San MH	108	towards upstream San MH	115	30.88	
Distance from downstream Stm MH	-	towards upstream Stm MH	-		

Power	Size	Communications	Size	Cable	Size	Gas	Size
BC Hydro	-	Telus	-	Shaw	-	FortisBC	-
Overhead Service		Overhead Service		Overhead Service			

Installed by:	City of Prince George forces	Survey Date:	-
Comments:			

NOT TO SCALE The information contained herein is for internal use only.
Not to be relied on unless confirmed by site inspection and/or investigation.

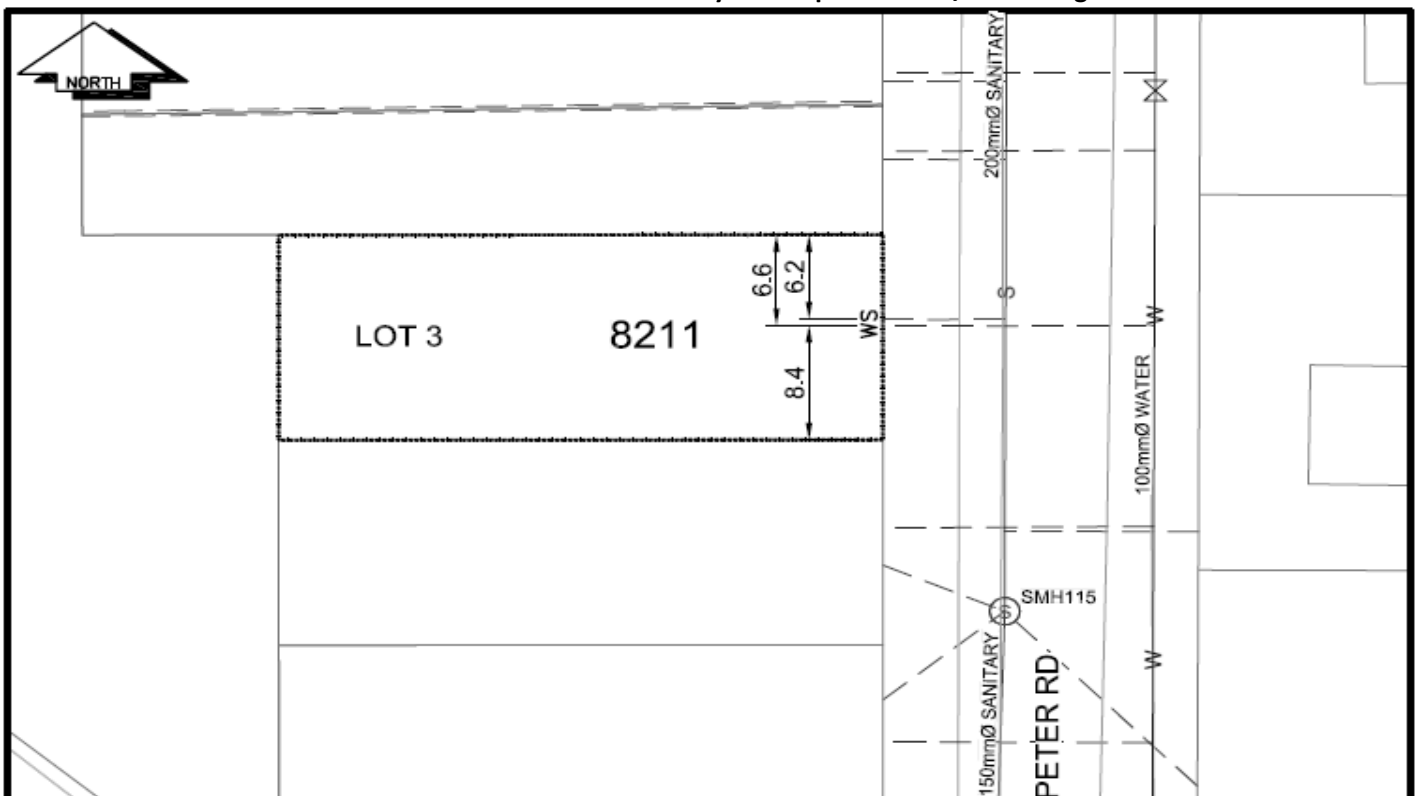

CS ^o CURB STOP	--- W --- WATER SERVICE	--- S --- SANITARY SERVICE	--- G --- GAS
CO ^o CLEAN OUT	--- S --- SANITARY SERVICE	--- W --- WATER SERVICE	--- E --- ENCUMBRANCE
⊗ WATER VALVE	⊗ FIRE HYDRANT		

NOT TO SCALE