



# City of Prince George History Sheet

PID:	030403383
SD/MU:	
WO:	

Civic Address: 3545 Chartwell Ave

Legal Description: Lot: A District Lot: 1599 Plan: EPP76701


Service Type	Diameter (mm)	Material	Invert Elev at main (m)	Invert Elev at property line (m)	Invert Elev at service end (m)	Distance into property (m)	Installation Date
Sanitary	100mm	PVC	-	741.79	-	-	december 1995
Water	20mm	Copper	-	-	-	-	December 2001
Storm	N/A	PVC	-	741.79	-	-	December 199

Service Connection Location				Sanitary (m)	Storm (m)
Distance from downstream San MH	4302	towards upstream San MH	4303	73.07	
Distance from downstream Stm MH	2312	towards upstream Stm MH	2073		14.44

Power	Size	Communications	Size	Cable	Size	Gas	Size
BC Hydro	-	Telus	-	Shaw	-	FortisBC	-
Underground Service		Underground Service		Underground Service			

Installed by:	Survey Date:	-
Comments:		

**NOT TO SCALE** The information contained herein is for internal use only.  
Not to be relied on unless confirmed by site inspection and/or investigation.

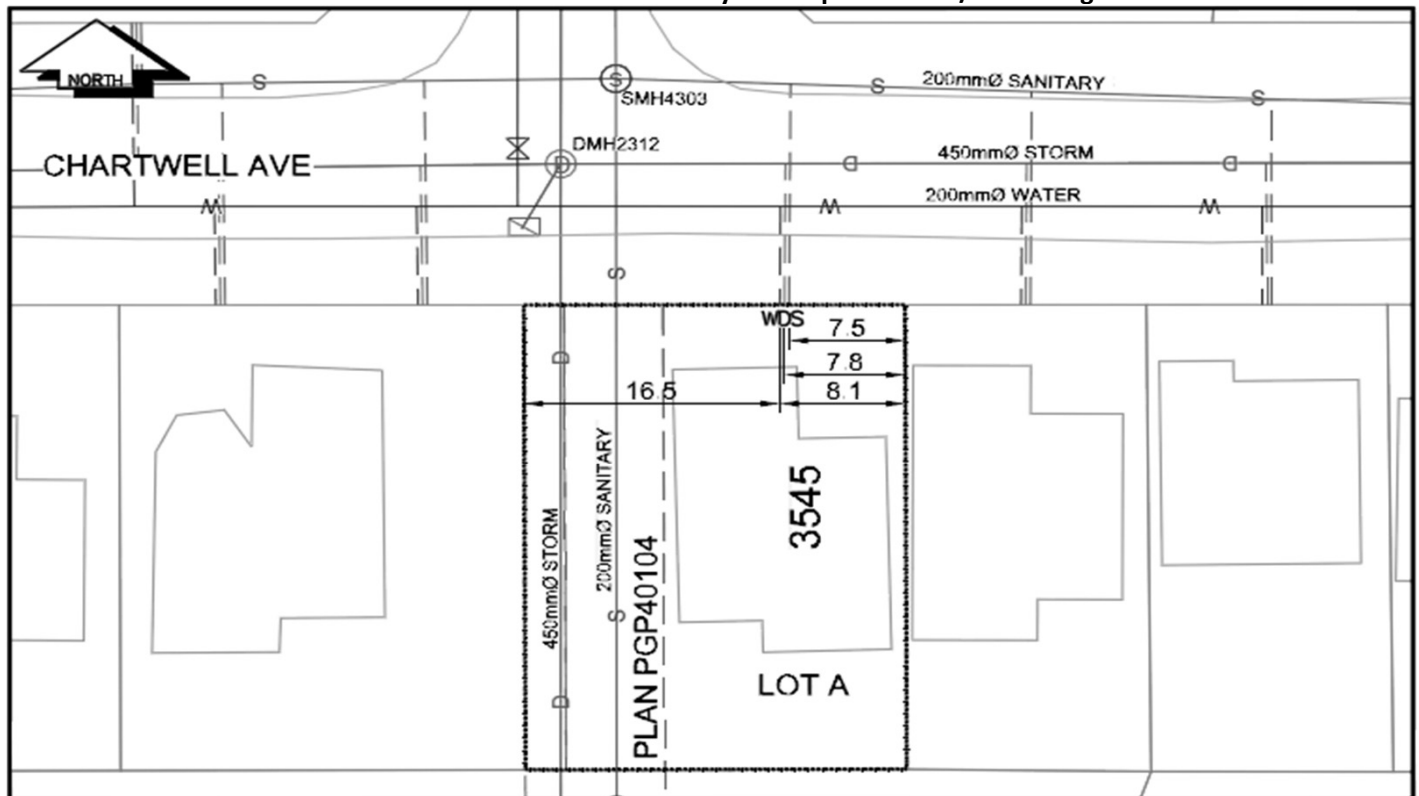

CS <sup>o</sup> CURB STOP	--- M --- WATER SERVICE	--- S --- STORM SERVICE
CO <sup>o</sup> CLEAN OUT	--- S --- SANITARY SERVICE	--- G --- GAS
⊗ WATER VALVE	⊗ FIRE HYDRANT	--- ENCUMBRANCE

**NOT TO SCALE**