



City of Prince George History Sheet

PID:	030403847
SD/MU:	
WO:	

Civic Address: 1755 Foothills Blvd (Bldg A) & 1759 Foothills Blvd (Bldg B)

Legal Description: Lot: 1 District Lot: 2508 Plan: EPP72103


Service Type	Diameter (mm)	Material	Invert Elev at main (m)	Invert Elev at property line (m)	Invert Elev at service end (m)	Distance into property (m)	Installation Date
Sanitary	200mm	PVC	-	-	-	-	December 1996
Water	200mm	AC	-	-	-	-	December 1997
Storm	250mm	AC	-	-	-	-	December 1996

Service Connection Location	Sanitary (m)	Storm (m)
200mm Sanitary service connected to San MH4026	-	
250mm Storm service connected to Stm MH1616		

Power	Size	Communications	Size	Cable	Size	Gas	Size
BC Hydro	-	Telus	-	Shaw	-	FortisBC	-
Overhead Service		Overhead Service		Overhead Service			

Installed by:	Survey Date:	-
Comments:		

NOT TO SCALE The information contained herein is for internal use only.
Not to be relied on unless confirmed by site inspection and/or investigation.

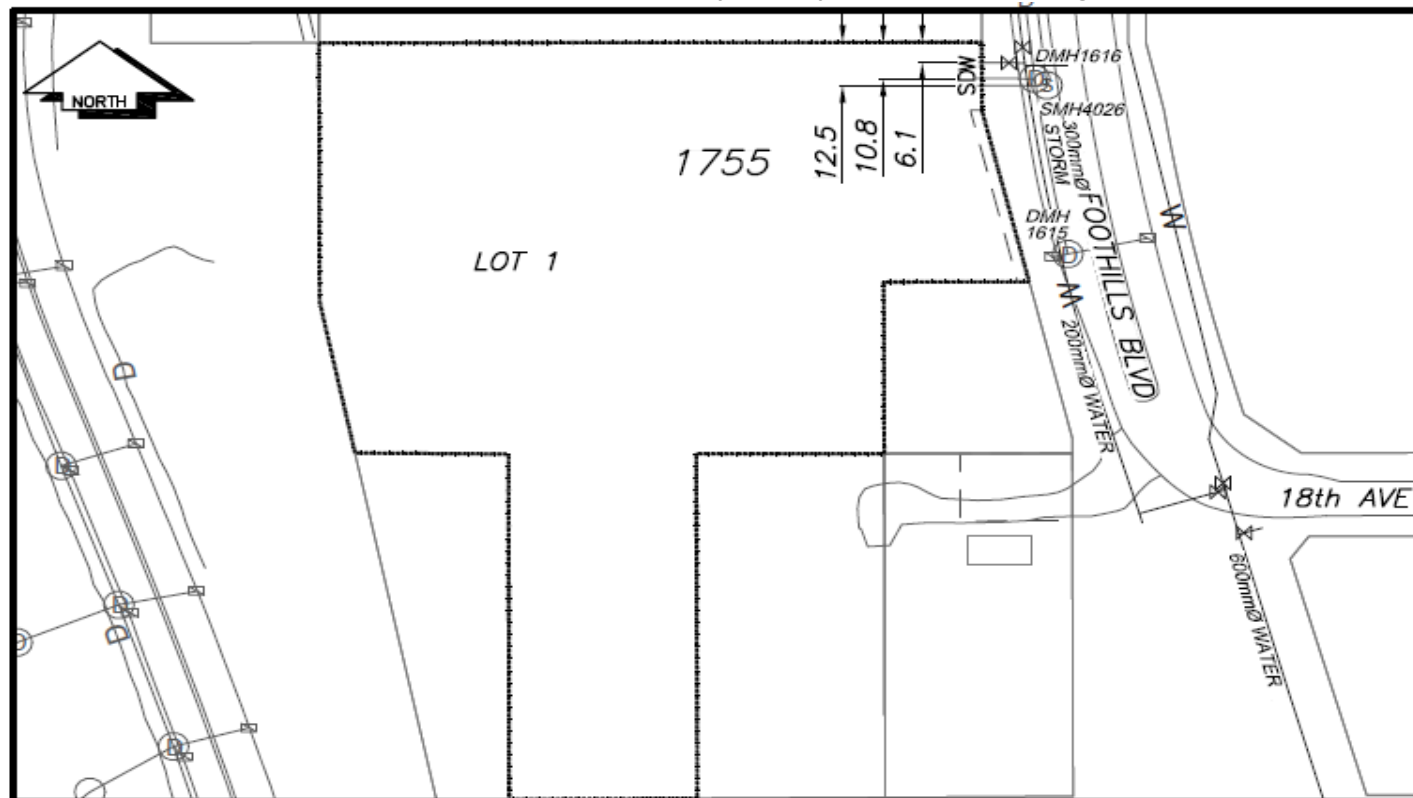

CS	CURB STOP	—X—	WATER SERVICE	—O—	STORM SERVICE
CO	CLEAN OUT	- - - -	SANITARY SERVICE	—G—	GAS
⊗	WATER VALVE	⊗	FIRE HYDRANT	- - - -	ENCUMBRANCE

NOT TO SCALE