



CITY OF
PRINCE GEORGE

City of Prince George HISTORY SHEET

PID:	030-463-459
SD/MU:	SD100538
WO:	

CIVIC ADDRESS: 2730 Recplace Drive

LEGAL DESCRIPTION: 4

D.L.8180

EPP76632


SERVICE TYPE	DIAMETER (mm)	MATERIAL	INVERT ELEV AT MAIN (m)	INVERT ELEV AT PROPERTY LINE (m)	INVERT ELEV AT SERVICE END (m)	COVER AT PROPERTY LINE (m)	DISTANCE INTO PROPERTY (m)	INSTALLATION DATE
SANITARY	200mm	PVC	589.64	589.65	N/A	2.00	N/A	August 2017
WATER	50mm	PVC	588.37*	N/A	N/A	2.69*	N/A	August 2017

STORM IS ONSITE INFILTRATION

ELECTRICAL / COMMUNICATIONS / GAS			
TYPE	PROVIDER	SIZE AND MATERIAL	LOCATION (UNDERGROUND/ OVERHEAD)
ELECTRICAL	BC HYDRO	1x100mm DB2 / H2: 3x75mm DB2	UNDERGROUND
COMMUNICATION	TELUS	1x100mm DB2	UNDERGROUND
COMMUNICATION	SHAW	1x100mm DP2	UNDERGROUND
GAS	FORTISBC	114 PROP/P.E.	UNDERGROUND

INFORMATION SHEETS: L&M ENGINEERING LIMITED PROJECT NUMBER 1502-01	SURVEY DATE: SEPT_2017
INSTALLED BY: DATOFF BROS CONSTRUCTION	
COMMENTS: Municipal sanitary and water mains within unregistered SRW Plan EPP76633	
* Municipal water main to the fire hydrant mid lot 4, the property service starts at the hydrant tee	
The sanitary main and service to the building is insulated with 50mm Rigid HI40	

THE INFORMATION CONTAINED HEREIN IS FOR INTERNAL USE ONLY.
NOT TO BE RELIED UPON UNLESS CONFIRMED BY SITE INVESTIGATION.

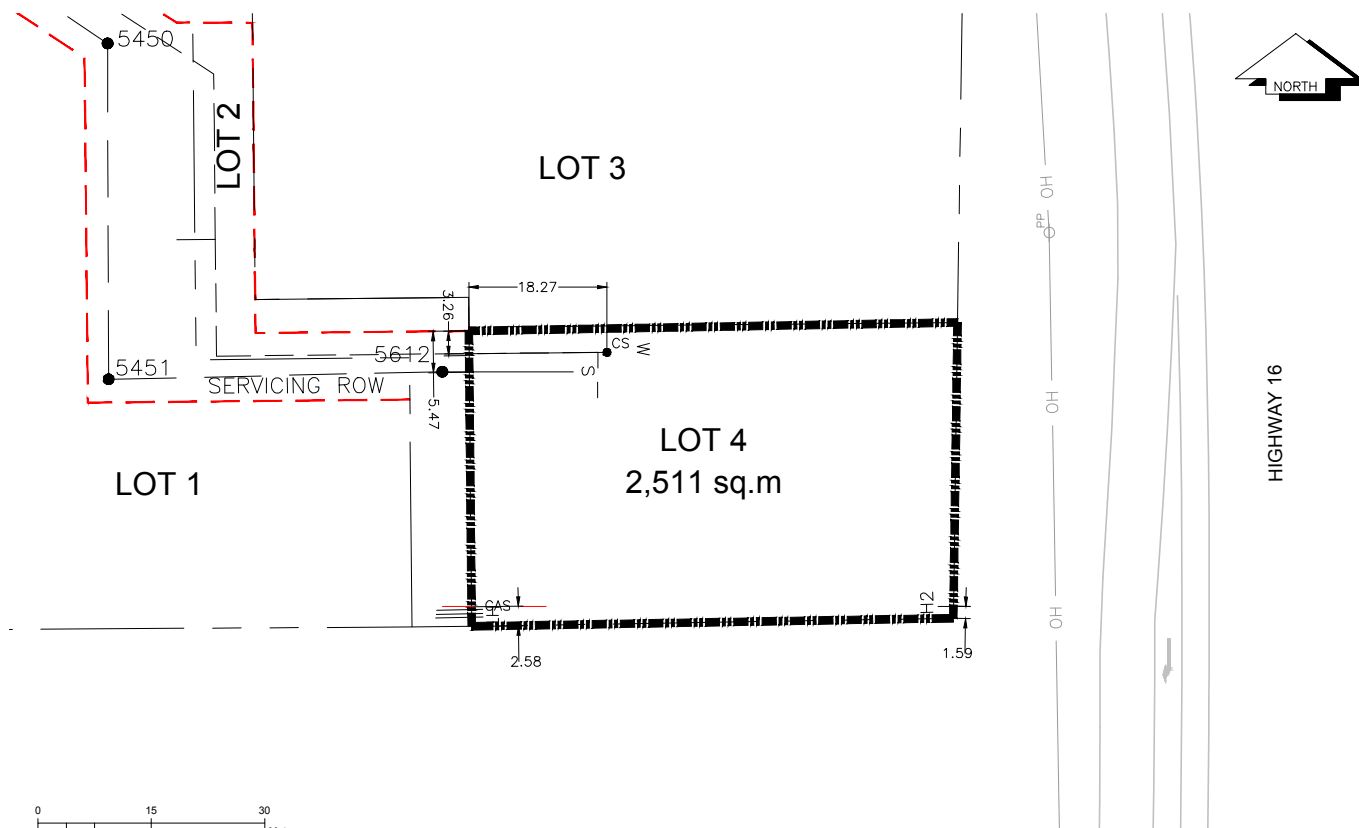

LEGEND:

CS ● CURB STOP	— W — WATER SERVICE	— H — HYDRO SERVICE	— G — GAS
CO ● CLEAN OUT	— S — STORM SERVICE	— T — TELECOMMUNICATIONS	— E — ELECTRICAL
	— S — SANITARY SERVICE		