



City of Prince George History Sheet

PID:	030467381
SD/MU:	
WO:	

Civic Address: 3429 Westwood Dr

Legal Description: Lot: 1 District Lot: 1433 Plan: EPP82693


Service Type	Diameter (mm)	Material	Invert Elev at main (m)	Invert Elev at property line (m)	Invert Depth at service end (m)	Distance into property (m)	Installation Date
Sanitary - north	100mm	PVC	-	586.67	2.13	-	December 1975
Sanitary - south	100mm	PVC	-	586.67	2.41	-	December 1975
Water - north	20mm	Copper	-	-	-	-	December 1966
Water - south	20mm	Copper	-	-	-	-	December 1966
Storm	N/A	N/A	-	-	-	-	

Service Connection Location					Sanitary (m)	Storm (m)
Distance from downstream San MH	4094	towards upstream San MH	4110		20.98	
Distance from downstream San MH	4094	towards upstream San MH	4110		29.48	
Distance from downstream Stm MH	-	towards upstream Stm MH	-			
Distance from downstream Stm MH	-	towards upstream Stm MH	-			

Power	Size	Communications	Size	Cable	Size	Gas	Size
BC Hydro	-	Telus	-	Shaw	-	FortisBC	-
Overhead Service		Overhead Service		Overhead Service			

Installed by:	Survey Date:	-
Comments:		

NOT TO SCALE The information contained herein is for internal use only.
Not to be relied on unless confirmed by site inspection and/or investigation.

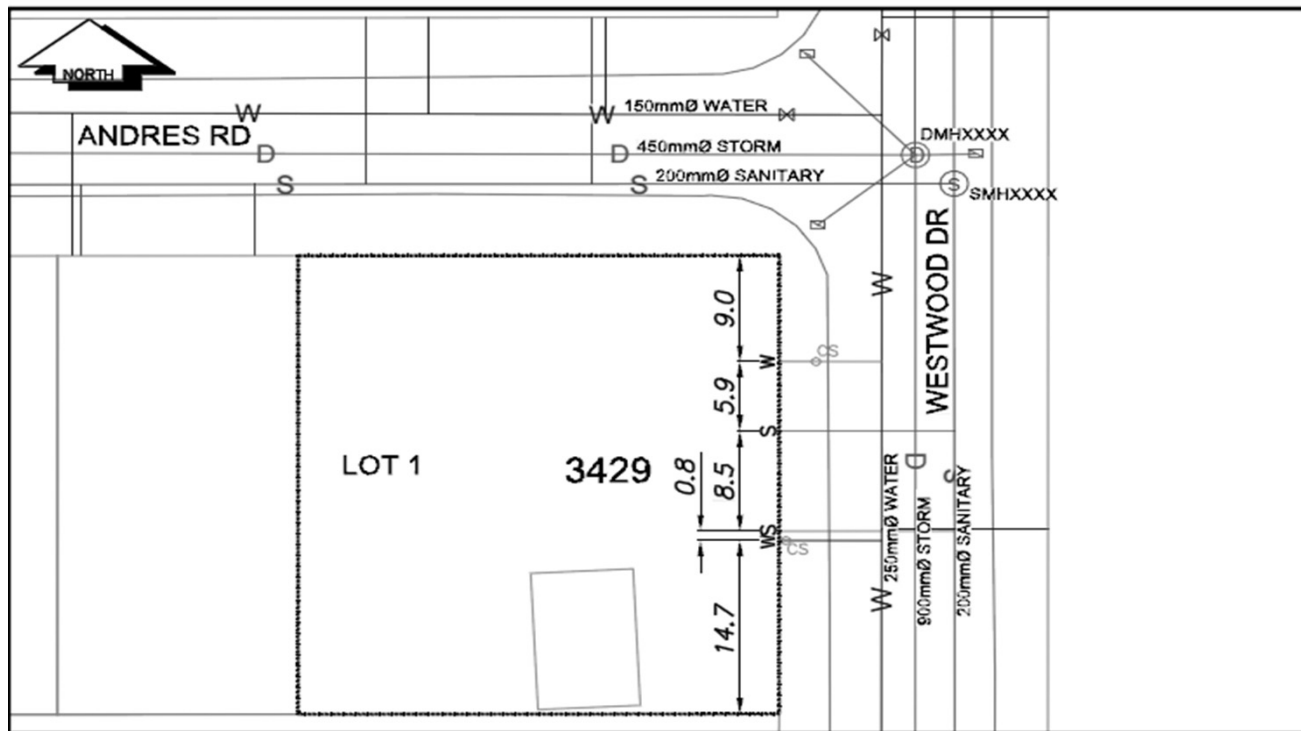

CS CURB STOP	W WATER SERVICE	○ STORM SERVICE
CO CLEAN OUT	- - - - - SANITARY SERVICE	- G - GAS
⊕ WATER VALVE	⊕ FIRE HYDRANT	- - - - - ENCUMBRANCE

NOT TO SCALE