

# City of Prince George

## HISTORY SHEET

PID: ~~029-852-081~~ 030-487-617

Scale: 1:500

Legal: ~~LOT 12~~ Lot A

D.L.: 2003

PLAN: ~~EPP52840~~ EPP78700

Address: 1141 MONTEITH CRT

Sanitary Connection:#	SIZE: 100mmØ	MATERIAL: PVC	INV. AT R 678.41m	CONNECTED
-----------------------	--------------	---------------	-------------------	-----------

Water Connection:#	SIZE: 19mmØ	MATERIAL: COPPER	INV. AT R 678.33m	CONNECTED
--------------------	-------------	------------------	-------------------	-----------

Storm Connection:#	SIZE: 100mmØ	MATERIAL: PVC	INV. AT R 678.41m	CONNECTED
--------------------	--------------	---------------	-------------------	-----------

Cash Receipt No's:	WATER	SANITARY	STORM
--------------------	-------	----------	-------

CURB FROM PROPERTY LINE	5m	PAVEMENT WIDTH	10m
-------------------------	----	----------------	-----

HYDRO	75mm DB2	U/G CONNECTION	✓
-------	----------	----------------	---


TELEPHONE	100mm DB2	U/G CONNECTION	✓
-----------	-----------	----------------	---

GAS	42 PROP/P.E.		
-----	--------------	--	--

Information Sheets: REF. DWGS. L&M ENGINEERING LTD. JOB. 1265-10 DWGS.

Comments: CS CURB STOP CO CLEAN OUT SDW WATER SERVICE STORM SERVICE SANITARY SERVICE HTC HYDRO SERVICE CABLE SERVICE TELECOMMUNICATIONS GAS GAS E ELECTRICAL

THE INFORMATION CONTAINED HEREIN IS FOR INTERNAL USE ONLY.  
NOT TO BE RELIED UPON UNLESS CONFIRMED BY THE SITE INSPECTION AND/OR INVESTIGATION

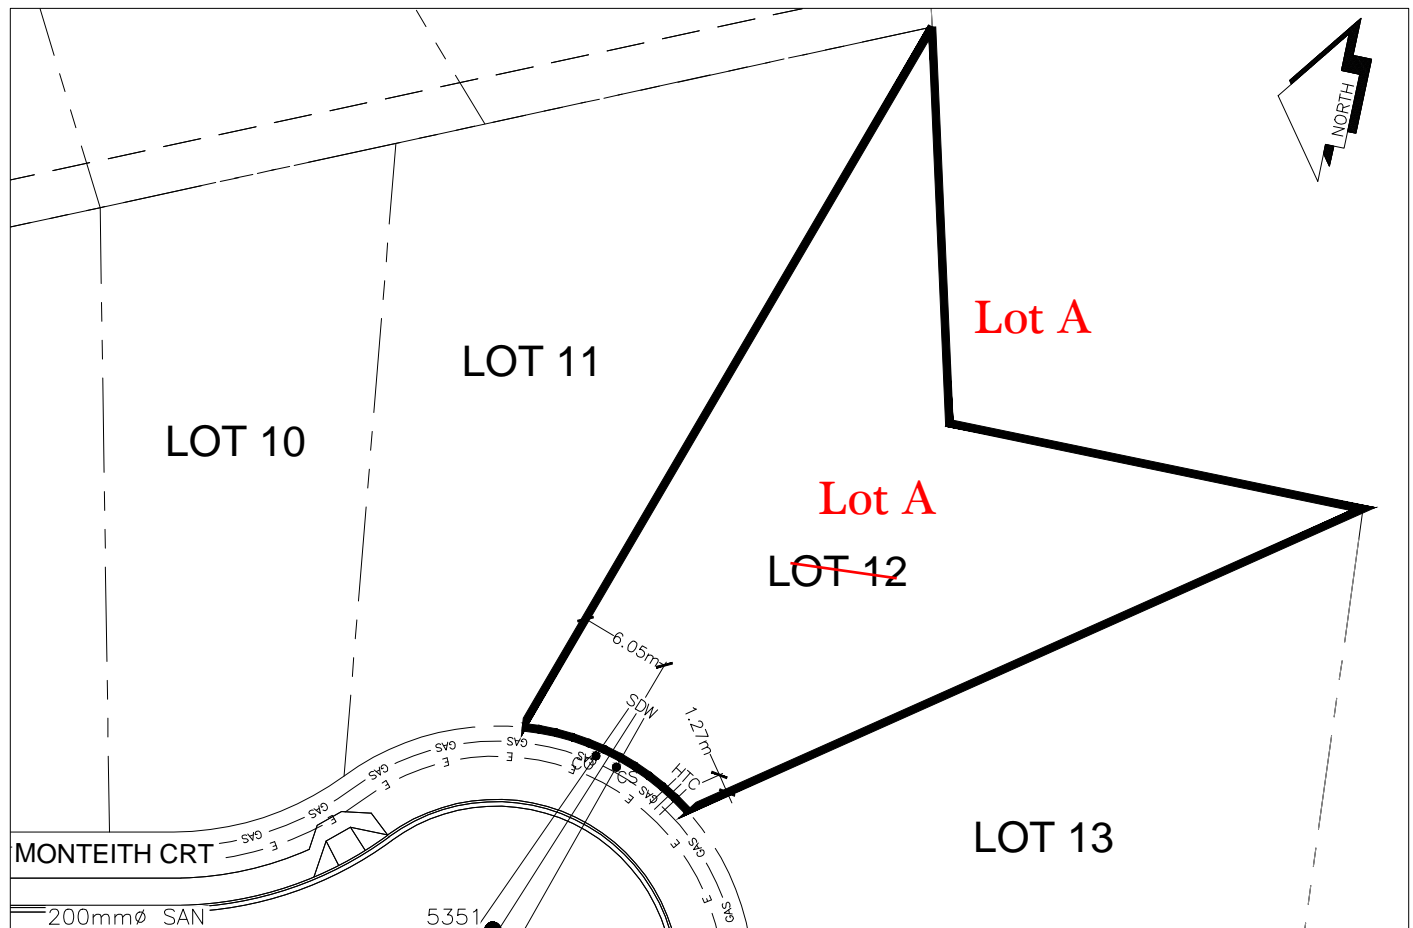

SANITARY, STORM & WATER SERVICE INVERTS	SANITARY	WATER	STORM
1. Distance from San. M.H. <u>5351</u> toward San. M.H. <u>5350</u> to lot service connection point is:	0.75m	N/A	N/A
1a.Distance from Stm. M.H. <u>3934</u> toward Stm. M.H. <u>3935</u> to lot service connection point is:	N/A	N/A	1.00m
2. Main Size at connection point is	200mmØ	200mmØ	250mmØ
3. Invert of service at main conn. stub point is	677.27m	677.11m	677.78m
4. Invert at service end is	678.46m	678.44m	678.48m
5. Cover at property line in meters	2.39m	2.55m	2.39m
6. Survey Date:AUG 2014    Book Ref.:1265-10    By:SHARP CONSTRUCTION			

SANITARY HISTORY:

DATE INSTALLED: AUG 2014

INSTALLED BY: SHARP CONSTRUCTION

WATER HISTORY:

DATE INSTALLED: AUG 2014

INSTALLED BY: SHARP CONSTRUCTION

STORM HISTORY:

DATE INSTALLED: AUG 2014

INSTALLED BY: SHARP CONSTRUCTION