



City of Prince George
History Sheet

PID:	030523168
SD:	100550
WO:	

Civic Address: 854 Alward St

Legal Description: Lot: A District Lot: 343 Plan: EPP79352


Service Type	Diameter (mm)	Material	Invert Elev at main (m)	Invert Elev at property line (m)	Invert Depth at service end (m)	Distance into property (m)	Installation Date
Sanitary	100mm	AC	-	586.41	2.28	-	December 1956
Water	20mm	Copper	-	-	-	-	December 1957
Storm	N/A	N/A	-	-	-	-	

Service Connection Location				Sanitary (m)	Storm (m)
Distance from downstream San MH	1986	towards upstream San MH	1977	90.91	
Distance from downstream Stm MH	-	towards upstream Stm MH	-		

Power	Size	Communications	Size	Cable	Size	Gas	Size
BC Hydro	-	Telus	-	Shaw	-	FortisBC	-
Overhead Service		Overhead Service		Overhead Service			

Installed by:	Survey Date:	-
Comments:		

NOT TO SCALE The information contained herein is for internal use only.
Not to be relied on unless confirmed by site inspection and/or investigation.

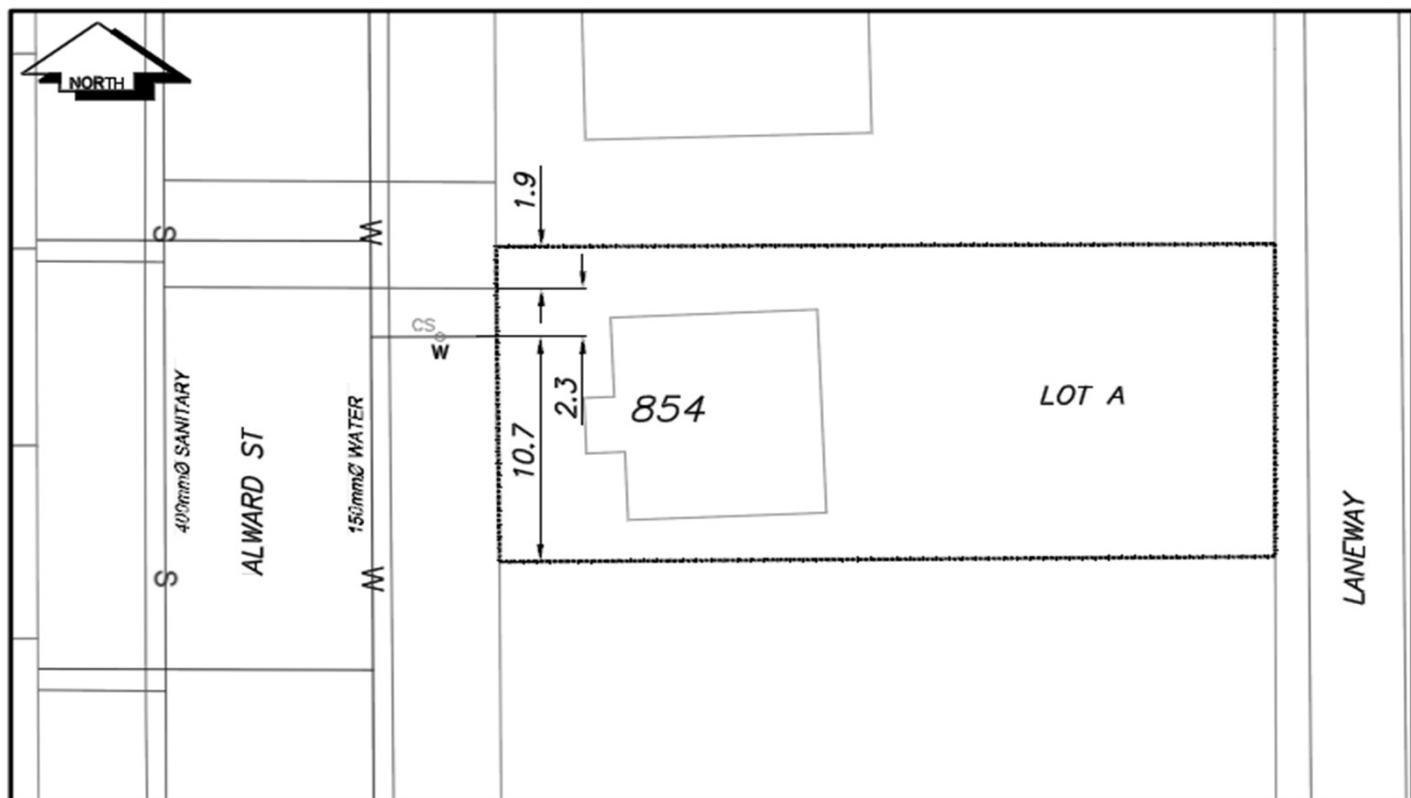

CS	CURB STOP	W	WATER SERVICE	M	STORM SERVICE
CO	CLEAN OUT	S	SANITARY SERVICE	G	GAS
X	WATER VALVE	FH	FIRE HYDRANT	X	ENCUMBRANCE

NOT TO SCALE