



City of Prince George
History Sheet

PID:	030532566
SD/MU:	
WO:	

Civic Address: 2130 McBride Cres

Legal Description: Lot: PCL D Block: 121 District Lot: 343 Plan: 1268


Service Type	Diameter (mm)	Material	Invert Elev at main (m)	Invert Elev at property line (m)	Invert Depth at service end (m)	Distance into property (m)	Installation Date
Sanitary	100mm	PVC	585.15	585.54	4.21	-	December 1956
Water	20mm	Copper	-	-	-	-	December 1956
Storm	N/A	N/A	-	-	-	-	

Service Connection Location				Sanitary (m)	Storm (m)
Distance from downstream San MH	2685	towards upstream San MH	2688	6.10	
Distance from downstream Stm MH	-	towards upstream Stm MH	-		

Power	Size	Communications	Size	Cable	Size	Gas	Size
BC Hydro	-	Telus	-	Shaw	-	FortisBC	-
Overhead Service		Overhead Service		Overhead Service			

Installed by:	Survey Date:	-
Comments:		

NOT TO SCALE The information contained herein is for internal use only.
Not to be relied on unless confirmed by site inspection and/or investigation.

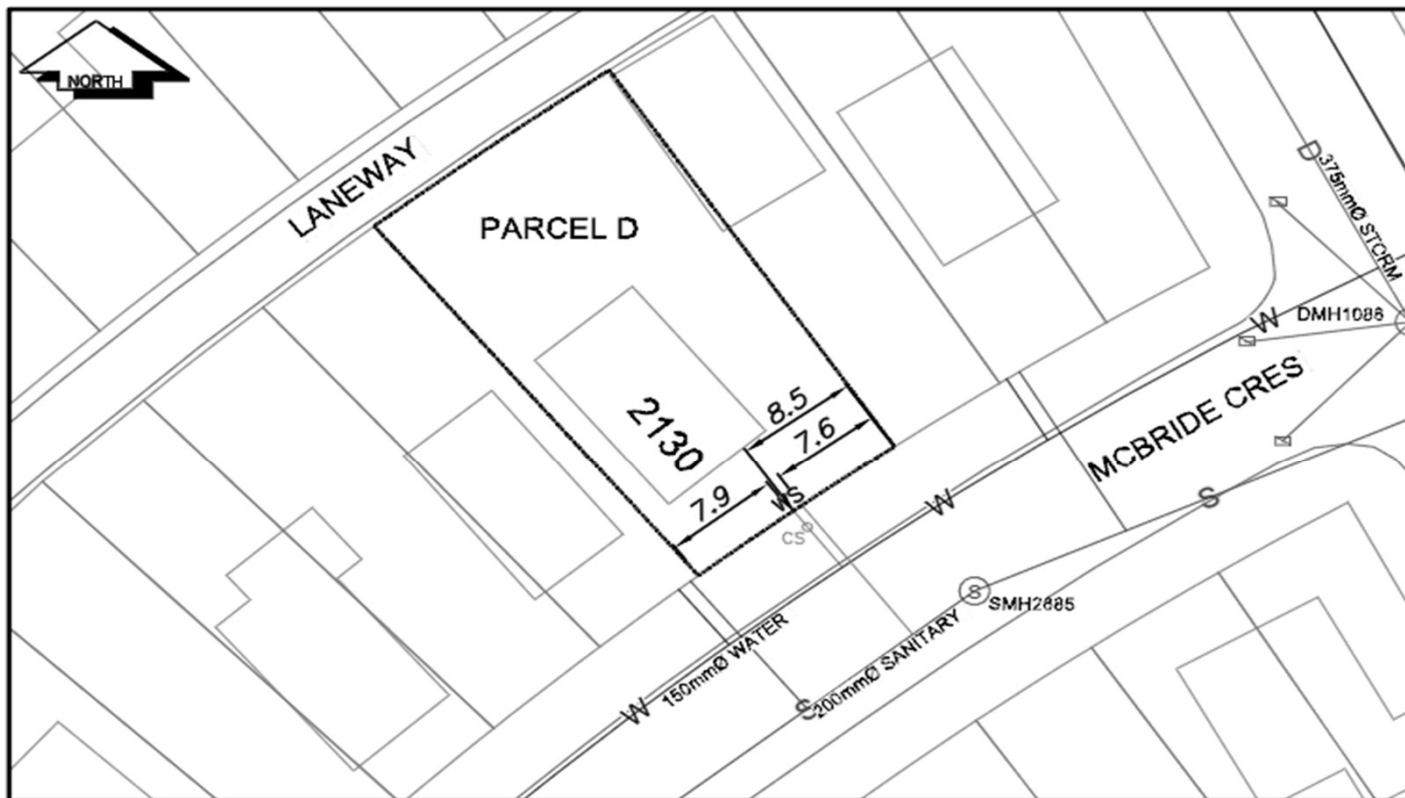

CS CURB STOP	W WATER SERVICE	Storm Service
CO CLEAN OUT	S SANITARY SERVICE	G GAS
Water Valve	Fire Hydrant	ENCUMBRANCE

NOT TO SCALE