



City of Prince George
History Sheet

PID:	030537363
SD/MU:	
WO:	

Civic Address: 5955 5965 Otway Rd

Legal Description: Lot: 3 District Lot: 1531 Plan: EPP67359


Service Type	Diameter (mm)	Material	Invert Elev at main (m)	Invert Elev at property line (m)	Invert Elev at service end (m)	Distance into property (m)	Installation Date
Sanitary	N/A	N/A	-	-	-	-	-
Water	N/A	N/A	-	-	-	-	
Storm	N/A	N/A	-	-	-	-	

Service Connection Location						Sanitary (m)	Storm (m)
Distance from downstream San MH			-	towards upstream San MH	-	-	
Distance from downstream Stm MH			-	towards upstream Stm MH	-		

Power	Size	Communications	Size	Cable	Size	Gas	Size
BC Hydro	-	Telus	-	Shaw	-	FortisBC	-
Overhead Service		Overhead Service		Overhead Service			

Installed by:	Survey Date:	-
Comments:		

NOT TO SCALE The information contained herein is for internal use only.
Not to be relied on unless confirmed by site inspection and/or investigation.

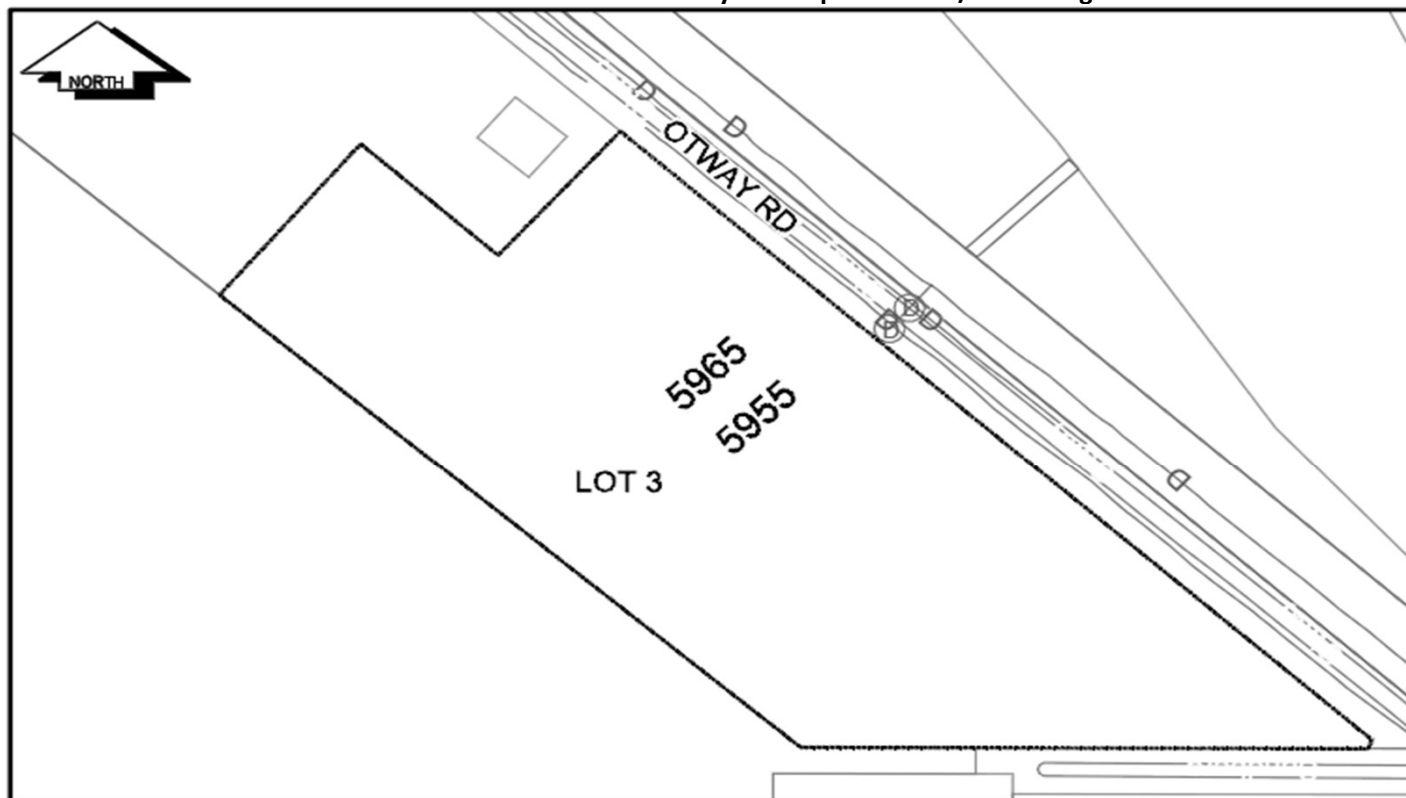

LEGEND:	CS ^o CURB STOP	— WATER SERVICE	— STORM SERVICE
	CO ^o CLEAN OUT	- - - - - SANITARY SERVICE	— G — GAS
	⊗ WATER VALVE	— ⊕ — FIRE HYDRANT	- - - - - ENCUMBRANCE

NOT TO SCALE