



City of Prince George History Sheet

PID:	030542154
SD/MU:	100513/101938
WO:	95411/95427

Civic Address: 1077 Terminal Blvd

Legal Description: Lot: A District Lot: 745 Plan: EPP62423


Service Type	Diameter (mm)	Material	Invert Elev at MH (m)	Invert Elev at property line (m)	Invert Elev at service end (m)	Distance into property (m)	Installation Date
Sanitary	200mm	PVC	587.75	587.80	587.80	0.30	September 2018
Water	150mm	PVC	588.14	588.10	588.10	1.50	September 2018
Storm	250mm	PVC	590.37	590.56	590.58	3.20	September 2018

Service Connection Location	Sanitary (m)	Storm (m)
200mm Sanitary service connected to new San MH	-	
250mm storm service connected to Stm MH1897		

Power	Size	Communications	Size	Cable	Size	Gas	Size
BC Hydro	-	Telus	-	Shaw	-	FortisBC	-
Overhead Service		Overhead Service		Overhead Service			

Installed by:	City of Prince George forces	Survey Date:	-
Comments:			

NOT TO SCALE The information contained herein is for internal use only.
Not to be relied on unless confirmed by site inspection and/or investigation.

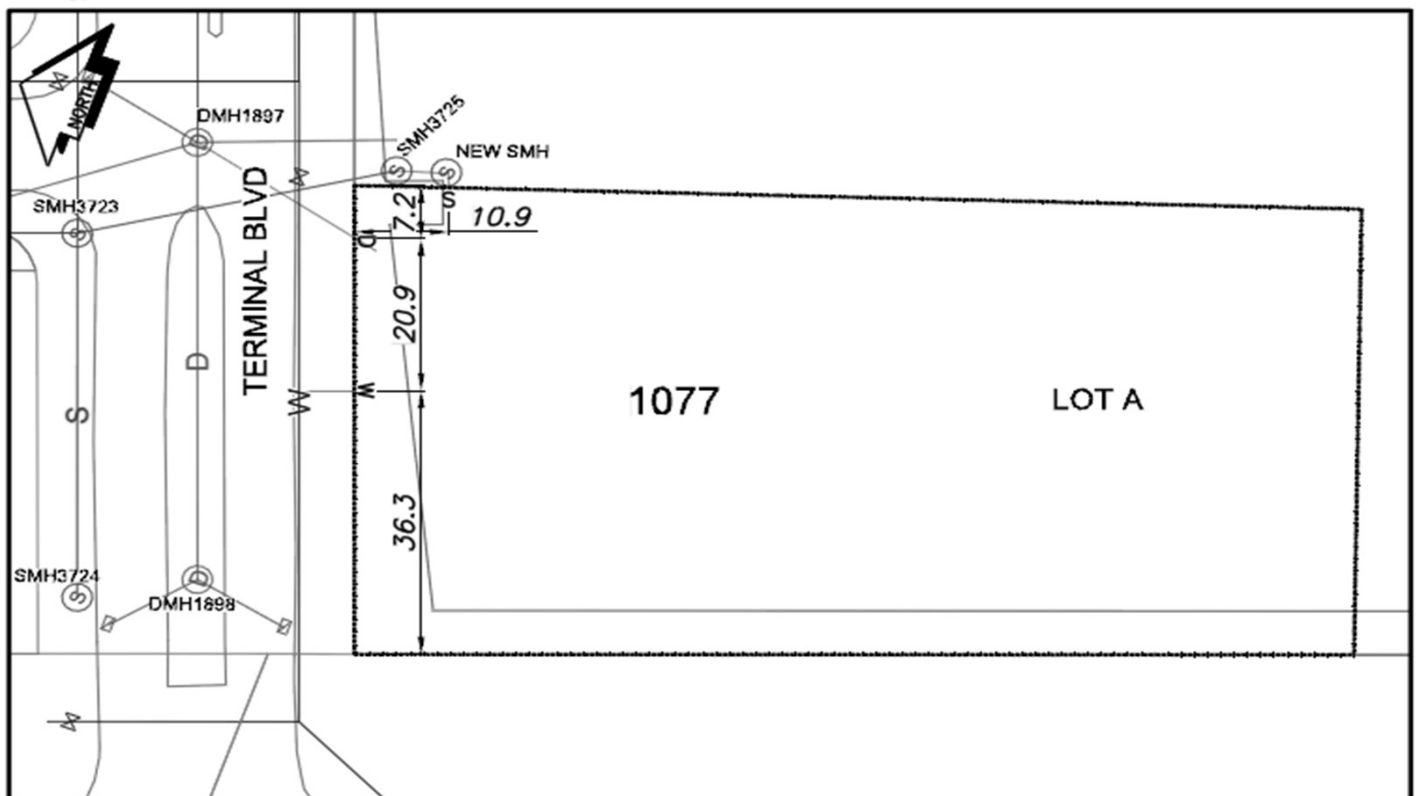

CS ^o CURB STOP	— W — WATER SERVICE	— S — STORM SERVICE
CO ^o CLEAN OUT	- - - S - SANITARY SERVICE	— G — GAS
⊗ WATER VALVE	⊗ FIRE HYDRANT	- - - - ENCUMBRANCE

NOT TO SCALE