



City of Prince George
History Sheet

| | |
|--------|-----------|
| PID: | 030543100 |
| SD/MU: | |
| WO: | |

Civic Address: 1646 Burden St

Legal Description: Lot: PCL K Block: 110 District Lot: 343 Plan: 1268


| Service Type | Diameter (mm) | Material | Invert Elev at main (m) | Invert Elev at property line (m) | Invert Elev at service end (m) | Distance into property (m) | Installation Date |
|--------------|---------------|----------|-------------------------|----------------------------------|--------------------------------|----------------------------|-------------------|
| Sanitary | N/A | N/A | - | - | - | - | - |
| Water | N/A | N/A | - | - | - | - | |
| Storm | N/A | N/A | - | - | - | - | |

| Service Connection Location | | | | | Sanitary (m) | Storm (m) |
|---------------------------------|---|-------------------------|---|--|--------------|-----------|
| Distance from downstream San MH | - | towards upstream San MH | - | | - | |
| Distance from downstream Stm MH | - | towards upstream Stm MH | - | | | |

| Power | Size | Communications | Size | Cable | Size | Gas | Size |
|------------------|------|------------------|------|------------------|------|----------|------|
| BC Hydro | - | Telus | - | Shaw | - | FortisBC | - |
| Overhead Service | | Overhead Service | | Overhead Service | | | |

| | | |
|---------------|--------------|---|
| Installed by: | Survey Date: | - |
| Comments: | | |
| | | |
| | | |

NOT TO SCALE The information contained herein is for internal use only.
Not to be relied on unless confirmed by site inspection and/or investigation.

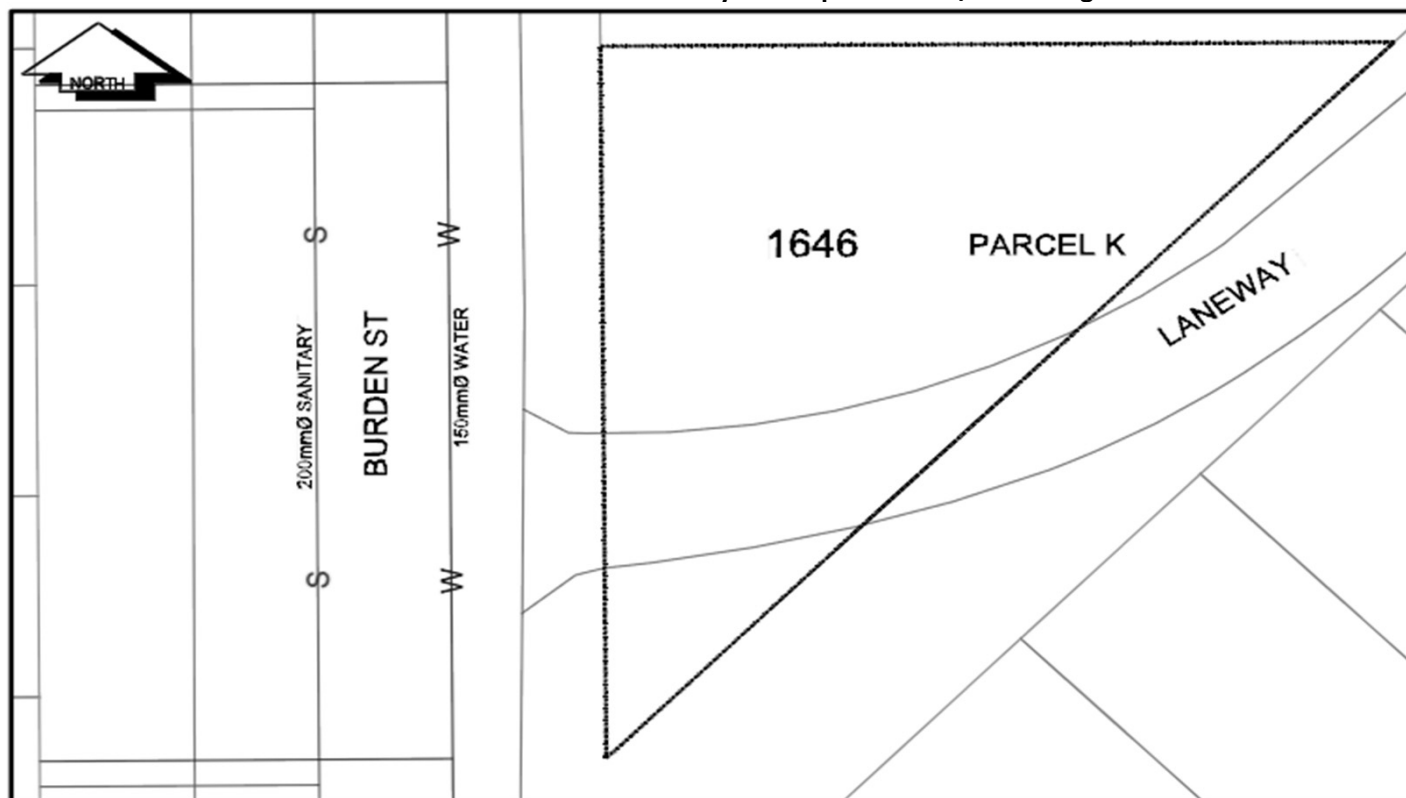

| | | |
|---------------------------|----------------------------|---------------------|
| CS ^o CURB STOP | — W — WATER SERVICE | — o — STORM SERVICE |
| CO ^o CLEAN OUT | - - - S - SANITARY SERVICE | — G — GAS |
| ⊗ WATER VALVE | ⊗ FIRE HYDRANT | - - - - ENCUMBRANCE |

NOT TO SCALE