



City of Prince George
History Sheet

PID:	030557518
SD/MU:	
WO:	

Civic Address: 4413 4427 4441 Glen Shee Rd
Legal Description: Lot: 1 District Lot: 2508 Plan: EPP85450


Service Type	Diameter (mm)	Material	Invert Elev at main (m)	Invert Elev at property line (m)	Invert Elev at service end (m)	Distance into property (m)	Installation Date
Sanitary (S1)	150mm	Vit	-	-	-	-	December 1971
Sanitary (S2)	150mm	Vit	-	-	-	-	December 1971
Sanitary (S3)	150mm	Vit	-	-	-	-	December 1971
Water (W1)	Unknown	Unknown	-	-	-	-	December 1978
Water (W2)	Unknown	Unknown	-	-	-	-	December 1978
Storm	N/A	N/A	-	-	-	-	

Service Connection Location	Sanitary (m)	Storm (m)
150mm Sanitary service connected to San MH815	-	
150mm Sanitary service connected to San MH815		
150mm Sanitary service connected to San MH814		

Power	Size	Communications	Size	Cable	Size	Gas	Size
BC Hydro	-	Telus	-	Shaw	-	FortisBC	-
Underground Service		Underground Service		Underground Service			

Installed by:	Survey Date:	-
Comments:		

NOT TO SCALE The information contained herein is for internal use only.
Not to be relied on unless confirmed by site inspection and/or investigation.

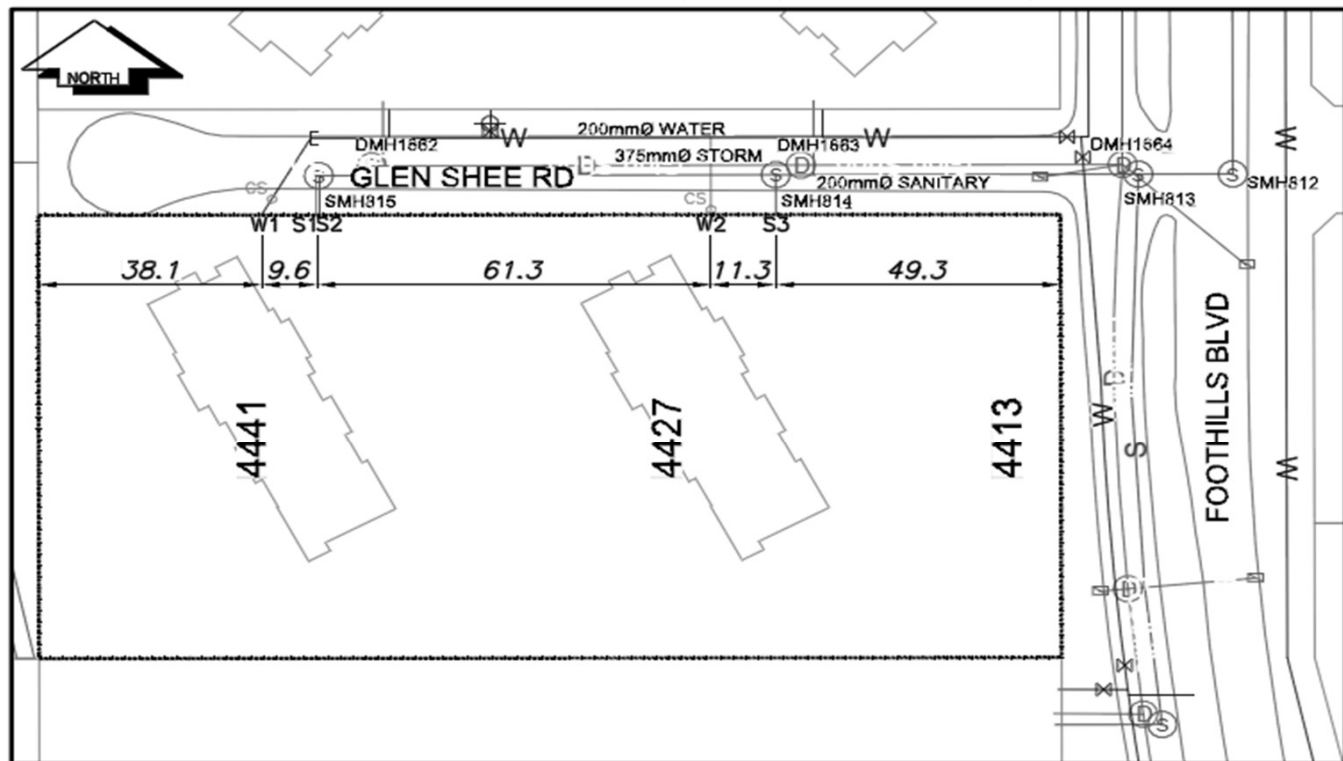

CS CURB STOP	W WATER SERVICE	S STORM SERVICE
CO CLEAN OUT	S SANITARY SERVICE	G GAS
WV WATER VALVE	F FIRE HYDRANT	E ENCUMBRANCE

NOT TO SCALE