



City of Prince George

## History Sheet

PID:	030571391
SD/MU:	
WO:	

Civic Address: 5350 Hartway Dr

Legal Description: Lot: PCL E District Lot: 4039 Plan: 28088


Service Type	Diameter (mm)	Material	Invert Elev at main (m)	Invert Elev at property line (m)	Invert Depth at service end (m)	Distance into property (m)	Installation Date
Sanitary (S1)	150mm	PVC	-	-	2.30	-	December 1980
Sanitary (S2)	150mm	PVC	-	-	2.80	-	December 1980
Sanitary (S3)	150mm	PVC	-	690.21	-	-	December 1980
Water (W1)	40mm	Copper	-	-	-	-	December 1980
Water (W2)	40mm	Copper	-	-	-	-	December 1980
Water (W3)	40mm	Copper	-	-	-	-	December 1980
Storm (D1)	150mm	PVC	-	-	2.40	-	December 1980
Storm (D2)	150mm	PVC	-	-	2.70	-	December 1980
Storm (D3)	150mm	PVC	-	690.18	-	-	December 1980

Service Connection Location				Sanitary (m)	Storm (m)
Distance from downstream San MH	951	towards upstream San MH	1209	28.31	
Distance from downstream San MH	951	towards upstream San MH	1209	63.88	
Distance from downstream San MH	951	towards upstream San MH	1209	86.28	
Distance from downstream Stm MH	2000	towards upstream Stm MH	1653		24.66
Distance from downstream Stm MH	2000	towards upstream Stm MH	1653		59.05
Distance from downstream Stm MH	2000	towards upstream Stm MH	1653		83.36

Power	Size	Communications	Size	Cable	Size	Gas	Size
BC Hydro	-	Telus	-	Shaw	-	FortisBC	-
Overhead Service		Overhead Service		Overhead Service			

Installed by:	Survey Date:	-
Comments:		

NOT TO SCALE The information contained herein is for internal use only.  
Not to be relied on unless confirmed by site inspection and/or investigation.

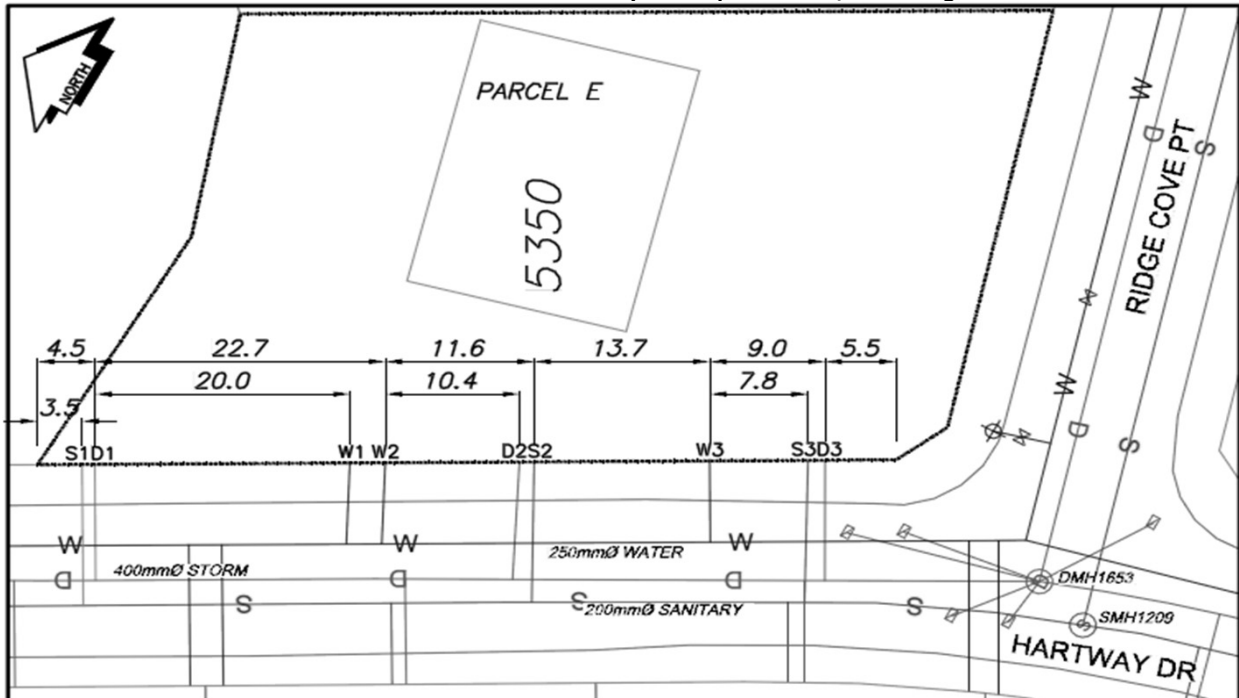

CS	CURB STOP	—	WATER SERVICE	—	STORM SERVICE
CO	CLEAN OUT	- - -	SANITARY SERVICE	— G —	GAS
⊗	WATER VALVE	—	FIRE HYDRANT	- - - -	ENCUMBRANCE

NOT TO SCALE