



# City of Prince George History Sheet

PID:	030571812
SD:	100559
WO:	

Civic Address: 4350 15th Ave

Legal Description: Lot: 1 District Lot: 2507 Plan: EPP84493


Service Type	Diameter (mm)	Material	Invert Elev at main (m)	Invert Elev at property line (m)	Invert Elev at service end (m)	Distance into property (m)	Installation Date
Sanitary	100mm	AC	-	-	-	-	December 1971
Water (W1)	25mm	Copper	-	-	-	-	December 1993
Water (W2)	25mm	Copper	-	-	-	-	December 1993
Storm	250mm	AC	-	-	-	-	December 1971

Service Connection Location				Sanitary (m)	Storm (m)
Distance from downstream San MH	817	towards upstream San MH	818	39.10	
Distance from downstream Stm MH	1669	towards upstream Stm MH	1670		88.61

Power	Size	Communications	Size	Cable	Size	Gas	Size
BC Hydro	-	Telus	-	Shaw	-	FortisBC	-
Underground Service		Underground Service		Underground Service			

Installed by:	Survey Date:	-
Comments:		

**NOT TO SCALE** The information contained herein is for internal use only.  
Not to be relied on unless confirmed by site inspection and/or investigation.

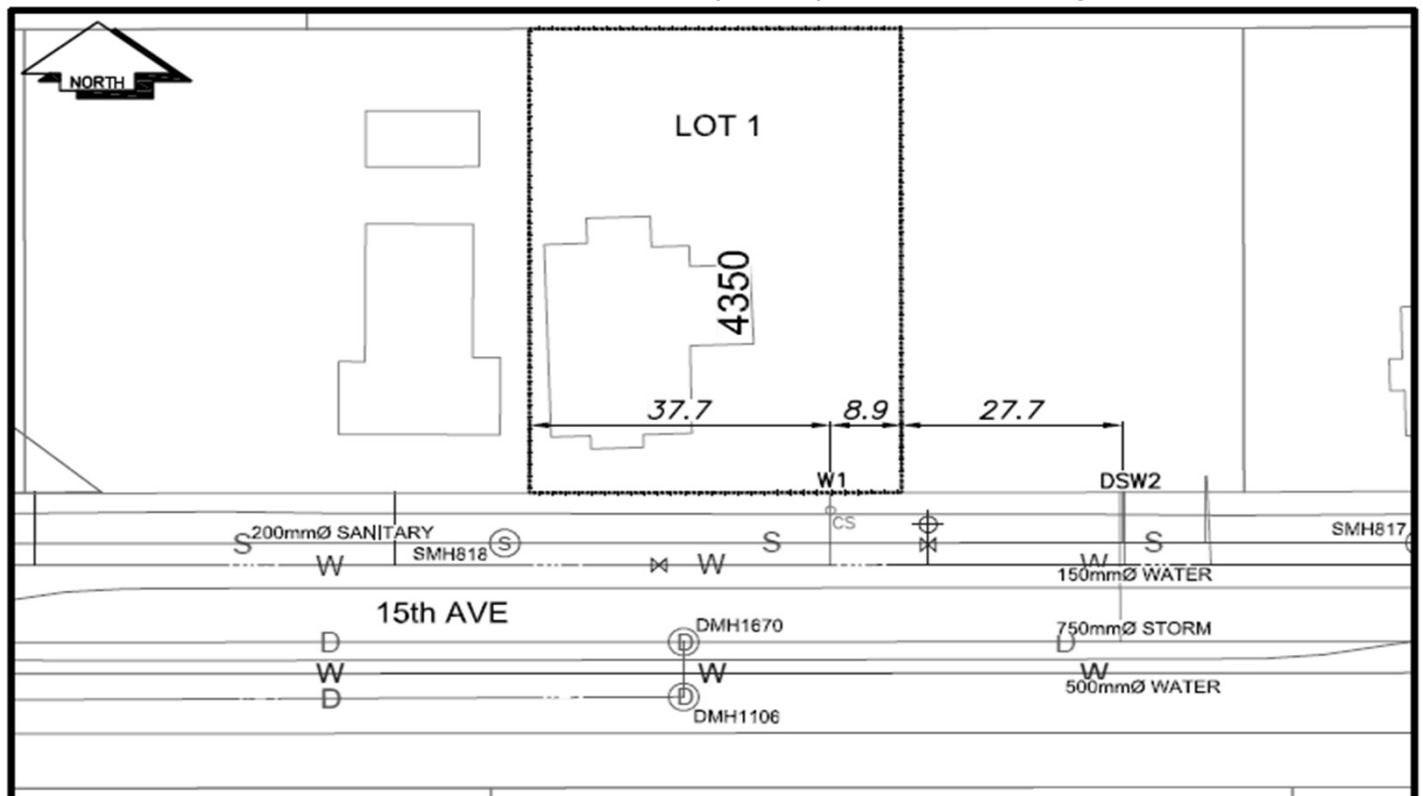

CS	CURB STOP	—	WATER SERVICE	—	STORM SERVICE
CO	CLEAN OUT	- - -	SANITARY SERVICE	—G—	GAS
⊗	WATER VALVE	⊗	FIRE HYDRANT	- - - - -	ENCUMBERANCE

**NOT TO SCALE**