



CITY OF
PRINCE GEORGE

City of Prince George HISTORY SHEET

PID:	030-587-034
SD/MU:	
WO:	

CIVIC ADDRESS: 2671 REDFIELD PLACE

LEGAL DESCRIPTION: LOT# 4 DISTRICT LOT 4377 PLAN EPP56990


SERVICE TYPE	DIAMETER (mm)	MATERIAL	INVERT ELEV AT MAIN (m)	INVERT ELEV AT PROPERTY LINE (m)	INVERT ELEV AT SERVICE END (m)	COVER AT PROPERTY LINE (m)	DISTANCE INTO PROPERTY (m)	INSTALLATION DATE
SANITARY	150mm	PVC	639.92m	640.16m	640.24	2.51m	3.0m	AUG 2020
WATER	150mm	PVC	639.12m	639.28m	639.31m	2.96m	2.7m	AUG 2014
STORM	N/A	N/A	N/A	N/A	N/A	N/A	N/A	N/A

*SEE COMMENTS

ELECTRICAL / COMMUNICATIONS / GAS			
TYPE	PROVIDER	SIZE AND MATERIAL	LOCATION (UNDERGROUND/ OVERHEAD)
ELECTRICAL	BC HYDRO	75mm DB2	UNDERGROUND
COMMUNICATION	TELUS	50mm DB2	UNDERGROUND
COMMUNICATION	SHAW	50mm DB2	UNDERGROUND
GAS	FORTISBC	42 PROP/P.E.	UNDERGROUND

INFORMATION SHEETS: L&M ENGINEERING LIMITED PROJECT NUMBER 1426-03	SURVEY DATE: 2015
INSTALLED BY: R.F. KLEIN & SONS	
COMMENTS: MUNICIPAL STORM SEWER CONNECTIONS ARE NOT REQUIRED. ALL STORM DRAINAGE IS TO BE ACCOMODATED ONSITE THROUGH GROUNDWATER INFILTRATION.	

THE INFORMATION CONTAINED HEREIN IS FOR INTERNAL USE ONLY.
NOT TO BE RELIED UPON UNLESS CONFIRMED BY SITE INVESTIGATION.

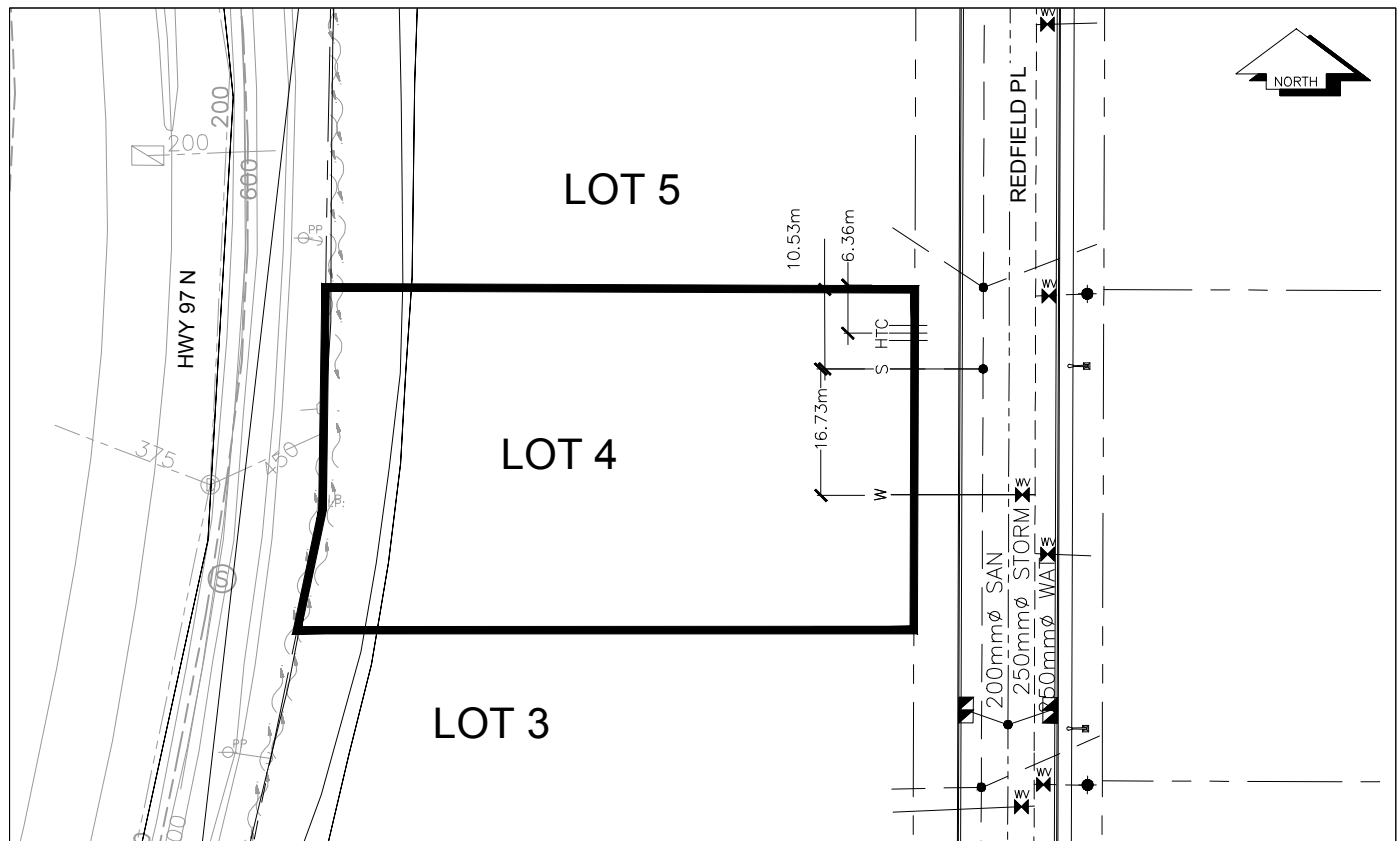

LEGEND:			
CS ● CURB STOP	— W WATER SERVICE	— H HYDRO SERVICE	— G GAS
CO ● CLEAN OUT	— S D STORM SERVICE	— T TELECOMMUNICATIONS	— E ELECTRICAL
	— S SANITARY SERVICE		