



CITY OF
PRINCE GEORGE

City of Prince George HISTORY SHEET

PID:	030-587-077
SD/MU:	
WO:	

CIVIC ADDRESS: 2820 REDFIELD PLACE

LEGAL DESCRIPTION: LOT# 7 DISTRICT LOT 4377 PLAN EPP56990

SERVICE TYPE	DIAMETER (mm)	MATERIAL	INVERT ELEV AT MAIN (m)	INVERT ELEV AT PROPERTY LINE (m)	INVERT ELEV AT SERVICE END (m)	COVER AT PROPERTY LINE (m)	DISTANCE INTO PROPERTY (m)	INSTALLATION DATE
SANITARY	150mm	PVC	641.51m	641.71m	641.71m	2.55m	0m	AUG 2014
WATER	150mm	PVC	641.05m	641.11m	641.11m	3.28m	3.0m	AUG 2014
STORM	N/A	N/A	N/A	N/A	N/A	N/A	N/A	N/A

ELECTRICAL / COMMUNICATIONS / GAS

TYPE	PROVIDER	SIZE AND MATERIAL	LOCATION (UNDERGROUND/ OVERHEAD)
ELECTRICAL	BC HYDRO	75mm DB2	UNDERGROUND
COMMUNICATION	TELUS	50mm DB2	UNDERGROUND
COMMUNICATION	SHAW	50mm DB2	UNDERGROUND
GAS	FORTISBC	42 PROP/P.E.	UNDERGROUND


INFORMATION SHEETS: L&M ENGINEERING LIMITED PROJECT NUMBER 1426-03

SURVEY DATE: 2015

INSTALLED BY: R.F. KLIEN & SONS

COMMENTS:

THE INFORMATION CONTAINED HEREIN IS FOR INTERNAL USE ONLY.
NOT TO BE RELIED UPON UNLESS CONFIRMED BY SITE INVESTIGATION.

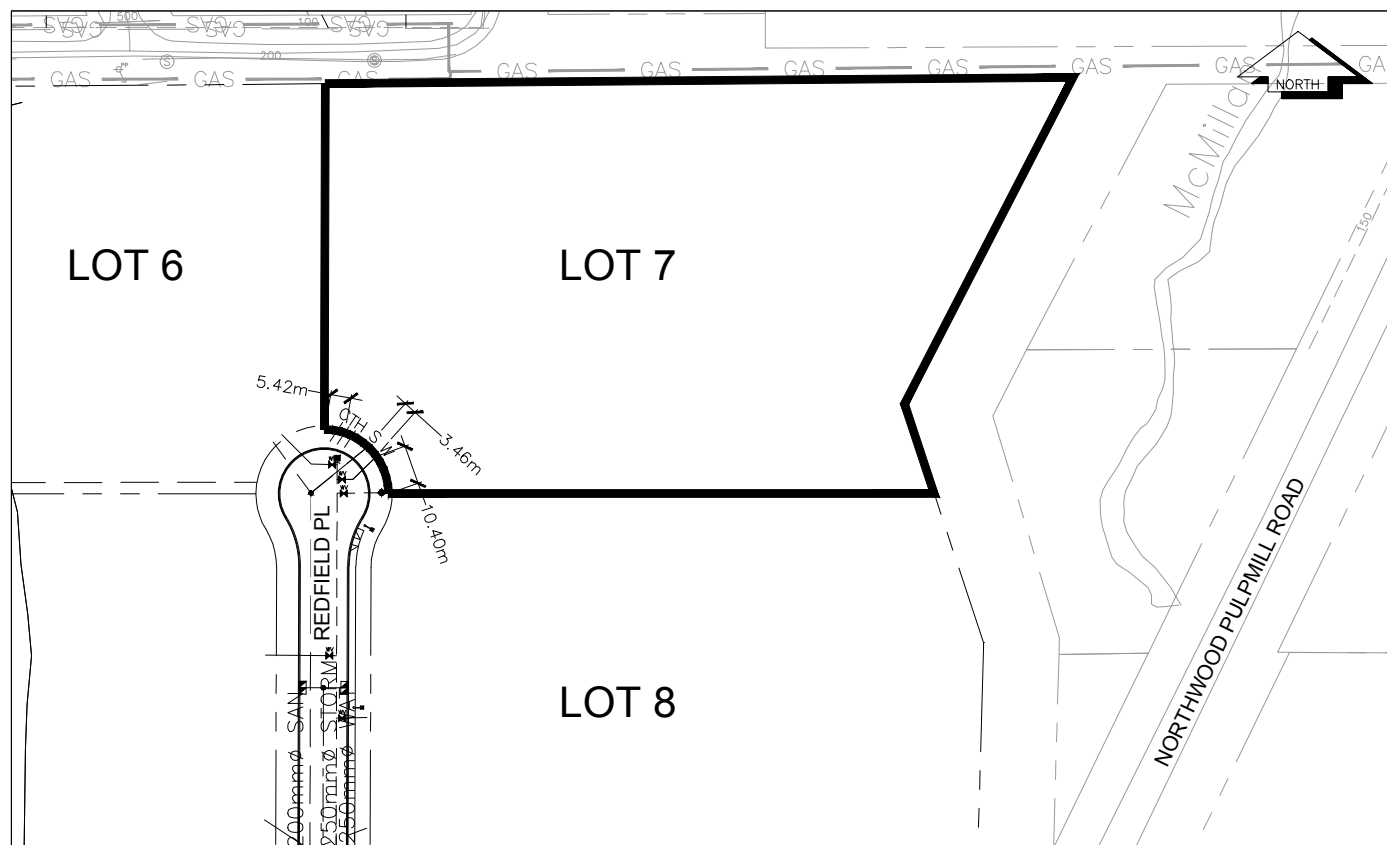

LEGEND:

CS CURB STOP
CO CLEAN OUT

W WATER SERVICE
S D W STORM SERVICE
S SANITARY SERVICE

H HYDRO SERVICE
T TELECOMMUNICATIONS

GAS GAS
E ELECTRICAL