



CITY OF  
PRINCE GEORGE

# City of Prince George HISTORY SHEET

PID:	030-587-093
SD/MU:	
WO:	

CIVIC ADDRESS: 2656 REDFIELD PLACE

LEGAL DESCRIPTION: LOT#9 DISTRICT LOT 4377 PLAN EPP56990

SERVICE TYPE	DIAMETER (mm)	MATERIAL	INVERT ELEV AT MAIN (m)	INVERT ELEV AT PROPERTY LINE (m)	INVERT ELEV AT SERVICE END (m)	COVER AT PROPERTY LINE (m)	DISTANCE INTO PROPERTY (m)	INSTALLATION DATE
SANITARY	150mm	PVC	639.11m	639.40m	639.40m	2.35m	0m	AUG 2014
WATER	150mm	PVC	639.05m	639.03m	639.03m	3.07m	0m	AUG 2014
STORM	*SEE COMMENTS	N/A	N/A	N/A	N/A	N/A	N/A	N/A

## ELECTRICAL / COMMUNICATIONS / GAS

TYPE	PROVIDER	SIZE AND MATERIAL	LOCATION ( UNDERGROUND/ OVERHEAD)
ELECTRICAL	BC HYDRO	75mm DB2	UNDERGROUND
COMMUNICATION	TELUS	50mm DB2	UNDERGROUND
COMMUNICATION	SHAW	50mm DB2	UNDERGROUND
GAS	FORTISBC	42 PROP/P.E.	UNDERGROUND


INFORMATION SHEETS: L&M ENGINEERING LIMITED PROJECT NUMBER 1426-03

SURVEY DATE: 2015

INSTALLED BY: R.F. KLEIN & SONS

COMMENTS: MUNICIPAL STORM SEWER CONNECTIONS ARE NOT REQUIRED. ALL STORM DRAINAGE IS TO BE ACCOMMODATED ONSITE THROUGH GROUNDWATER INFILTRATION. LOT OWNERS ARE TO EXTEND THE SANITARY AND WATER SERVICES TO THE PROPERTY LINE.

THE INFORMATION CONTAINED HEREIN IS FOR INTERNAL USE ONLY.  
NOT TO BE RELIED UPON UNLESS CONFIRMED BY SITE INVESTIGATION.

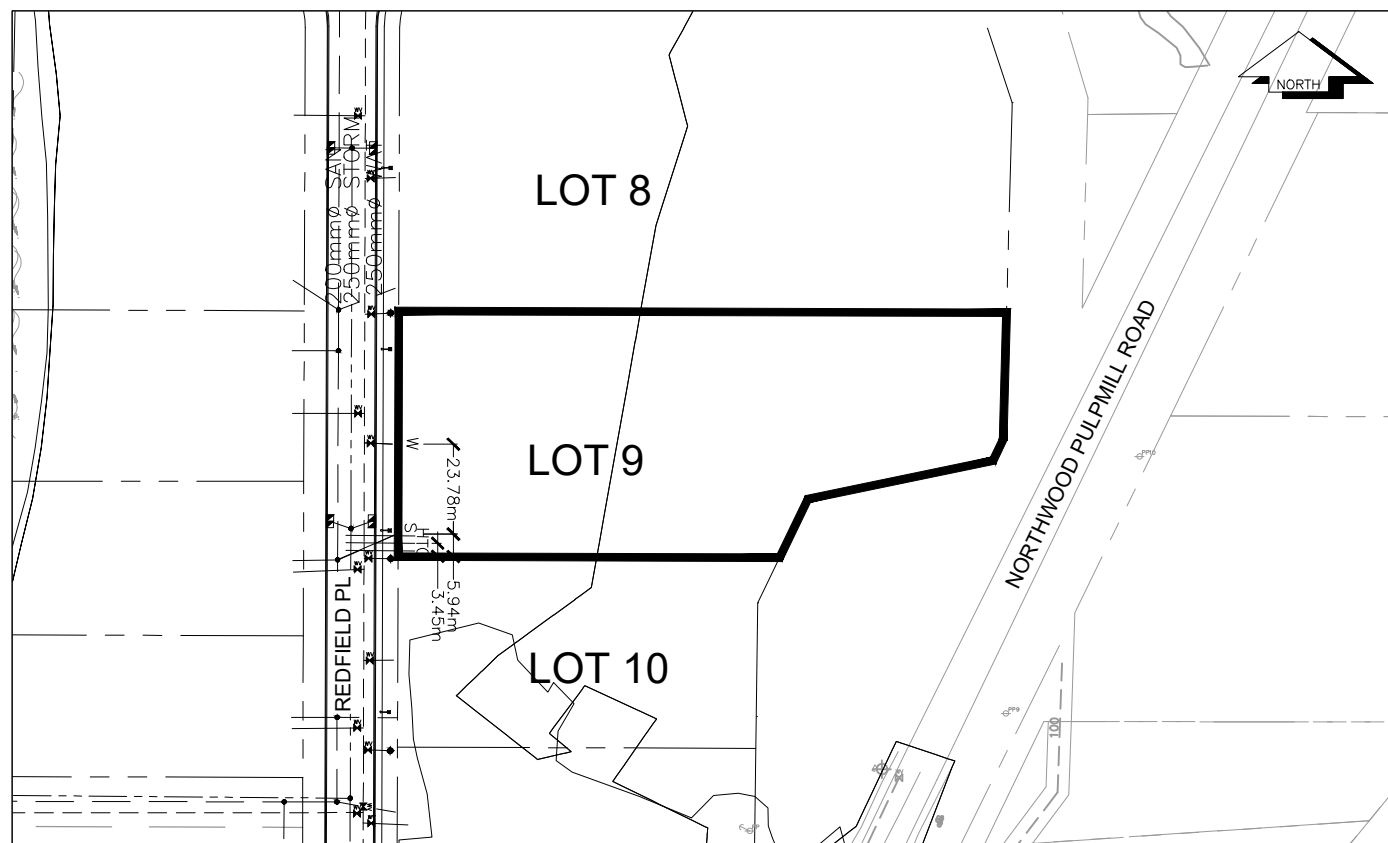

## LEGEND:

CS ● CURB STOP	— W — WATER SERVICE	— H — HYDRO SERVICE	— GAS — GAS
CO ● CLEAN OUT	— S D W — STORM SERVICE	— T — TELECOMMUNICATIONS	— E — ELECTRICAL
	— S — SANITARY SERVICE		