



CITY OF
PRINCE GEORGE

City of Prince George HISTORY SHEET

PID:	030-593-000
SD/MU:	SD100518
WO:	

CIVIC ADDRESS: 4185 ZANETTE PLACE


LEGAL DESCRIPTION: LOT 3 DISTRICT LOT 4376 PLAN EPP67523

SERVICE TYPE	DIAMETER (mm)	MATERIAL	INVERT ELEV AT MAIN (m)	INVERT ELEV AT PROPERTY LINE (m)	INVERT ELEV AT SERVICE END (m)	COVER AT PROPERTY LINE (m)	DISTANCE INTO PROPERTY (m)	INSTALLATION DATE
SANITARY	100	PVC	599.26	599.67	599.74	2.43	3.00	MAY 2016
WATER	19	COPPER	598.80	599.68	599.70	2.50	3.00	MAY 2016
STORM	N/A	N/A	N/A	N/A	N/A	N/A	N/A	N/A

ELECTRICAL / COMMUNICATIONS / GAS			
TYPE	PROVIDER	SIZE AND MATERIAL	LOCATION (UNDERGROUND/ OVERHEAD)
ELECTRICAL	BC HYDRO	75mm DB2	UNDERGROUND
COMMUNICATION	TELUS	50mm DB2	UNDERGROUND
COMMUNICATION	SHAW	50mm DB2	UNDERGROUND
GAS	FORTISBC	42 PROP/P.E.	UNDERGROUND

INFORMATION SHEETS: L&M ENGINEERING LIMITED PROJECT NUMBER 1145-20	SURVEY DATE: JUNE 2016
INSTALLED BY: JR CONSTRUCTION & CONSULTING SERVICES LTD.	
COMMENTS:	

THE INFORMATION CONTAINED HEREIN IS FOR INTERNAL USE ONLY.
NOT TO BE RELIED UPON UNLESS CONFIRMED BY SITE INVESTIGATION.

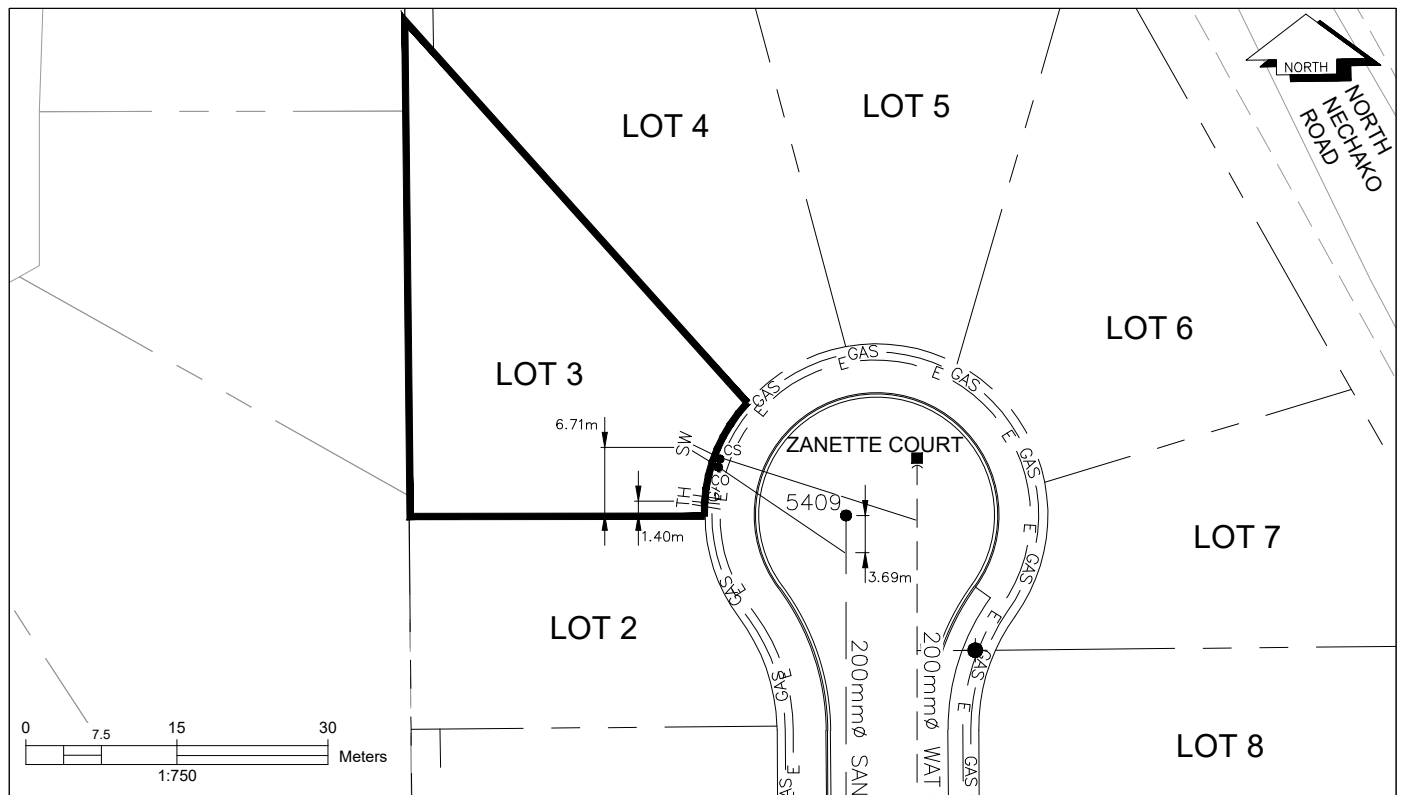

LEGEND:			
CS	CURB STOP	— W —	WATER SERVICE
CO	CLEAN OUT	— S D W —	STORM SERVICE
		— S —	SANITARY SERVICE
		— H —	HYDRO SERVICE
		— T —	TELECOMMUNICATIONS
		— GAS —	GAS
		— E —	ELECTRICAL