

LEGEND:

WATER VALVE

City of Prince George **History Sheet**

30638313	PID:
	SD/MU:
	WO:

— — ENCUMBERANCE

Civic Address: 6374 Hillcrest Pl

Legal Description: Lot: PCL A District Lot: 2003 Plan: PGP38074


Service Type	Diameter (mm)	Material	Invert Elev at main (m)	Invert Elev at property line (m)	Invert Elev at service end (m)	Distance into property (m)	Installation Date
Sanitary	100mm	PVC	-	-	-	-	December 1982
Water	20mm	Copper		-	=	-	December 1977
Storm	N/A	N/A	-	-	-	-	

Service Connection Location				Sanitary (m)	Storm (m)
Distance from downstream San MH	4166	towards upstream San MH	4237	44.67	
Distance from downstream Stm MH	-	towards upstream Stm MH	-		

Power	Size	Communications	Size	Cable	Size	Gas	Size
BC Hydro	-	Telus	-	Shaw	-	FortisBC	-
Overhead	l Service	Overhead	Service	Overhead	l Service		

Installed by:	Survey Date:	-
Comments:		

NOT TO SCALE The information contained herein is for internal use only. Not to be relied on unless confirmed by site inspection and/or investigation.

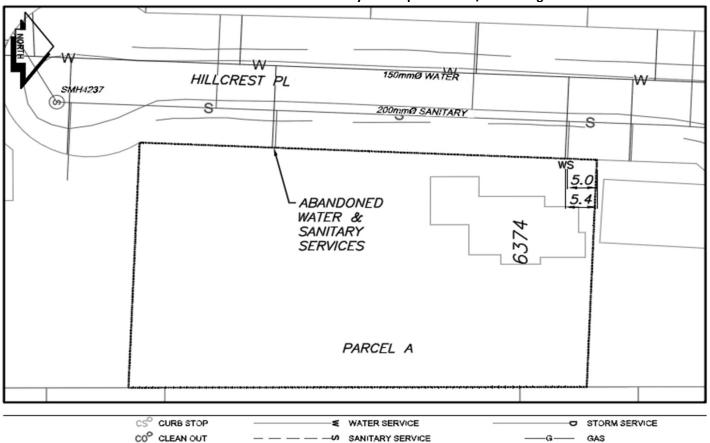

FIRE HYDRANT