



City of Prince George History Sheet

PID:	030664047
SD/MU:	101920
WO:	93263/93265

Civic Address: 1406 Freeman St

Legal Description: Lot: 1 District Lot: 1429 Plan: EPP86951


Service Type	Diameter (mm)	Material	Invert Elev at main (m)	Invert Elev at property line (m)	Invert Elev at service end (m)	Distance into property (m)	Installation Date
Sanitary	100mm	AC	-	-	-	-	December 1974
Water	20mm	Copper	-	-	-	-	September 2017
Storm	100mm	PVC	-	-	-	-	September 2017

Service Connection Location				Sanitary (m)	Storm (m)
Distance from downstream San MH	733	towards upstream San MH	737	110.76	
100mm storm service connected to Stm MH3224					

Power	Size	Communications	Size	Cable	Size	Gas	Size
BC Hydro	-	Telus	-	Shaw	-	FortisBC	-
Overhead Service		Overhead Service		Overhead Service			

Installed by:	City of Prince George forces	Survey Date:	-
Comments:			

NOT TO SCALE The information contained herein is for internal use only.
Not to be relied on unless confirmed by site inspection and/or investigation.

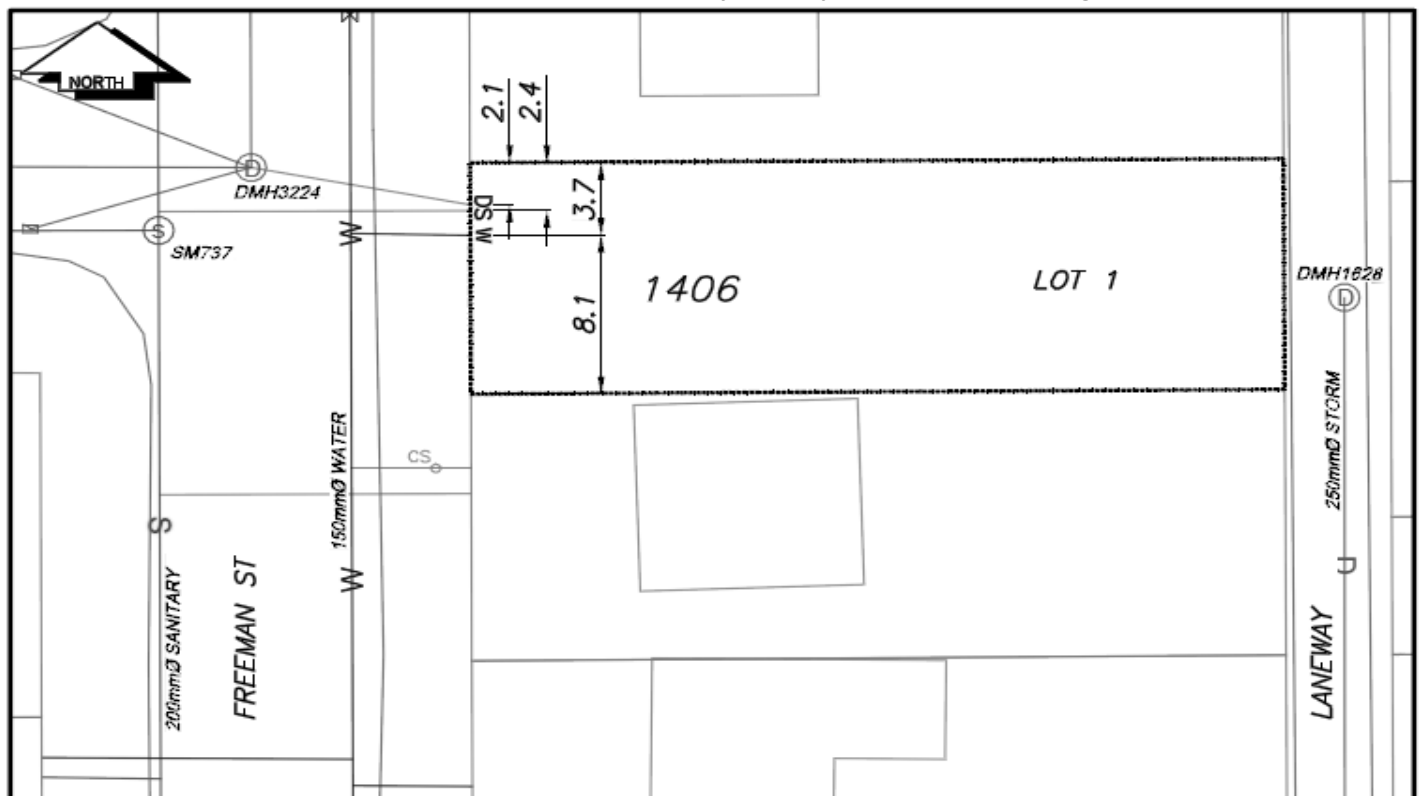

CS CURB STOP	W WATER SERVICE	STORM SERVICE
CO CLEAN OUT	S SANITARY SERVICE	G GAS
WATER VALVE	FIRE HYDRANT	ENCUMBRANCE

NOT TO SCALE