



City of Prince George History Sheet

PID:	030677459
SD	100561
WO:	

Civic Address: 2588, 2594 Recplace Dr

Legal Description: Lot: A District Lot: 8180 Plan: EPP78234


Service Type	Diameter (mm)	Material	Invert Elev at main (m)	Invert Elev at property line (m)	Invert Elev at service end (m)	Distance into property (m)	Installation Date
Sanitary	100mm	PVC	-	-	-	-	December 1981
Water	50mm	Copper	-	-	-	-	April 2015
Storm	N/A	N/A	-	-	-	-	

Service Connection Location	Sanitary (m)	Storm (m)
100mm Sanitary connected to San MH 5272	-	
Distance from downstream Stm MH - towards upstream Stm MH -		

Power	Size	Communications	Size	Cable	Size	Gas	Size
BC Hydro	-	Telus	-	Shaw	-	FortisBC	-
Overhead Service		Overhead Service		Overhead Service			

Installed by:	Survey Date:	-
Comments: Storm handled by onsite recharge chamber		

NOT TO SCALE The information contained herein is for internal use only.
Not to be relied on unless confirmed by site inspection and/or investigation.

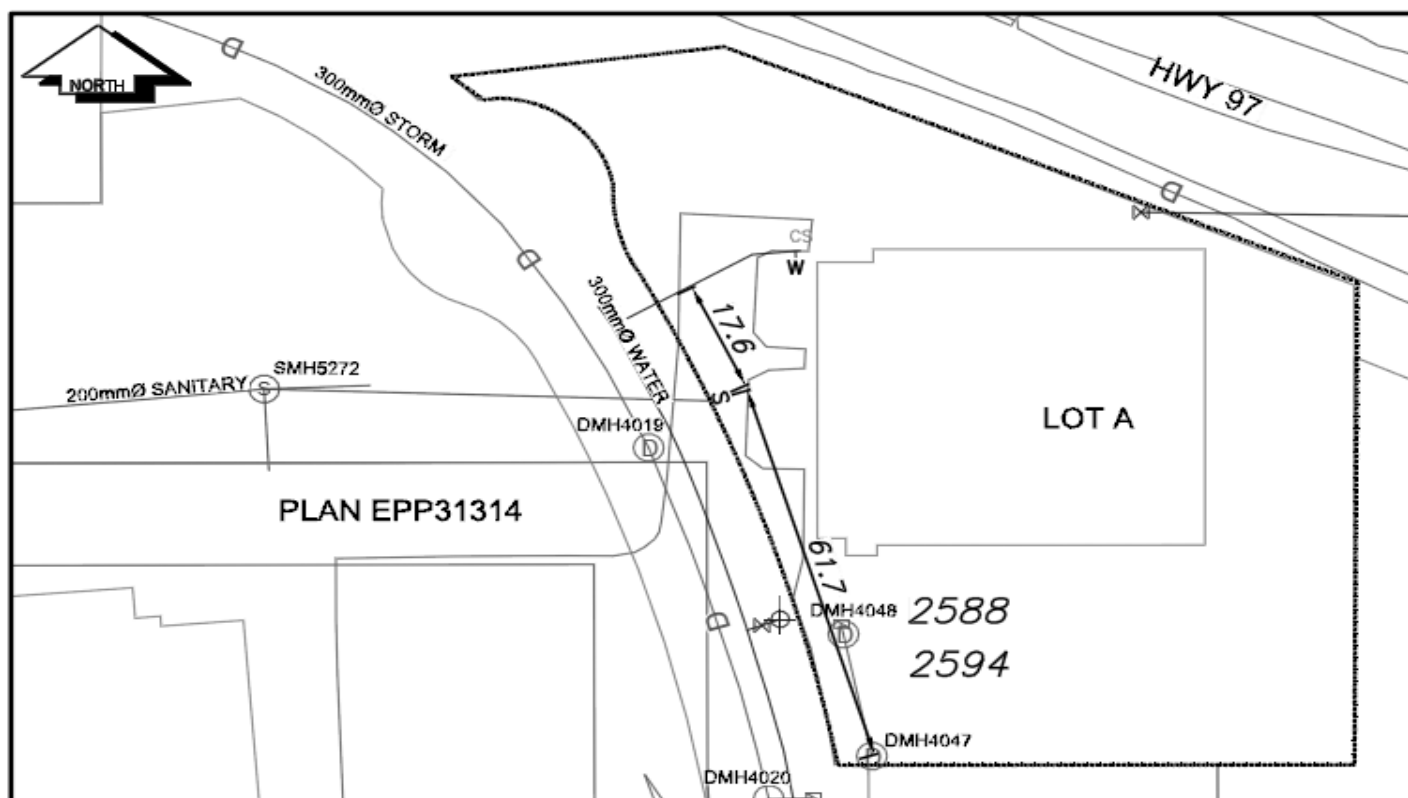

CS ^o CURB STOP	— W WATER SERVICE	— S STORM SERVICE
CO ^o CLEAN OUT	- - - S SANITARY SERVICE	— G GAS
⊗ WATER VALVE	⊗ FIRE HYDRANT	- - - ENCUMBRANCE

NOT TO SCALE