



CITY OF  
PRINCE GEORGE

# City of Prince George

## HISTORY SHEET

PID:	PID 030-689-805
SD/MU:	BP040405
WO:	

CIVIC ADDRESS: 718 FOREMAN ROAD

LEGAL DESCRIPTION: LOT1 DISTRICT LOT 954 PLAN EPP82193

SERVICE TYPE	DIAMETER (mm)	MATERIAL	INVERT ELEV AT MAIN (m)	INVERT ELEV AT PROPERTY LINE (m)	INVERT ELEV AT SERVICE END (m)	COVER AT PROPERTY LINE (m)	DISTANCE INTO PROPERTY (m)	INSTALLATION DATE
SANITARY	200mm	PVC	666.69	668.61	N/A	2.50	N/A	JULY 2020
WATER	200mm	PVC	675.33	375.32	N/A	2.51	N/A	JULY 2020
STORM	N/A	N/A	N/A	N/A	N/A	N/A	N/A	N/A

### ELECTRICAL / COMMUNICATIONS / GAS

TYPE	PROVIDER	SIZE AND MATERIAL	LOCATION ( UNDERGROUND/ OVERHEAD)
ELECTRICAL	BC HYDRO	75mm DB2	UNDERGROUND
COMMUNICATION	TELUS	50mm DB2	UNDERGROUND
COMMUNICATION	SHAW	50mm DB2	UNDERGROUND
GAS	FORTISBC	42 PROP/P.E.	UNDERGROUND


INFORMATION SHEETS: L&M ENGINEERING LIMITED PROJECT NUMBER 1509-15

SURVEY DATE: OCTOBER 2020

INSTALLED BY: NORTHWEST CONSTRUCTION

COMMENTS:

THE INFORMATION CONTAINED HEREIN IS FOR INTERNAL USE ONLY.  
NOT TO BE RELIED UPON UNLESS CONFIRMED BY SITE INVESTIGATION.

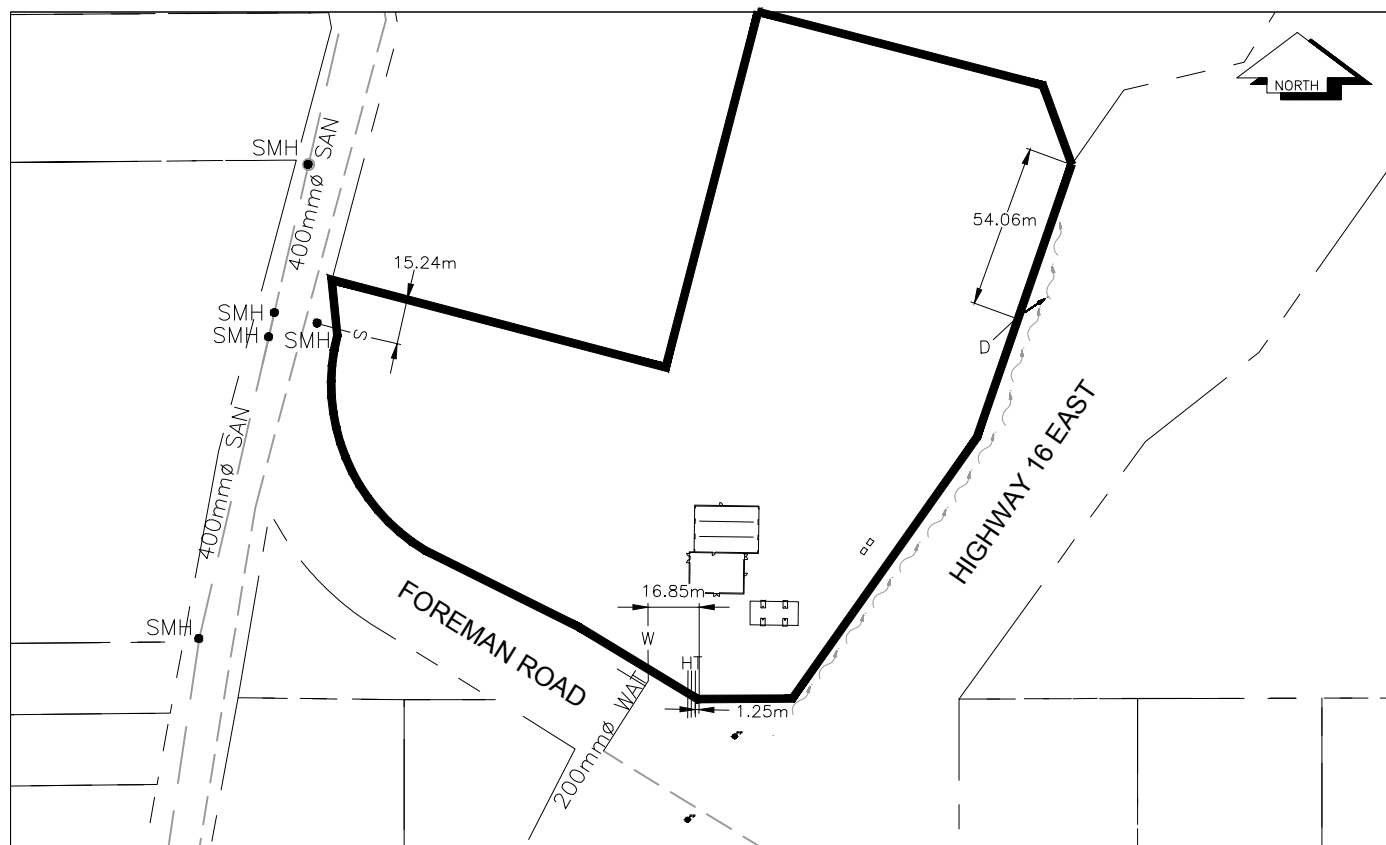

### LEGEND:

CS. CURB STOP  
CO. CLEAN OUT

— W WATER SERVICE  
— S D W STORM SERVICE  
— S SANITARY SERVICE

— H HYDRO SERVICE  
— T TELECOMMUNICATIONS

— GAS GAS  
— UG SHALLOW UTILITIES