



City of Prince George History Sheet

PID:	030703921
SD/MU:	
WO:	

Civic Address: 7040 Tony Rd

Legal Description: Lot: 2 District Lot: 1599 Plan: EPP50755


Service Type	Diameter (mm)	Material	Invert Elev at main (m)	Invert Elev at property line (m)	Invert Depth at service end (m)	Distance into property (m)	Installation Date
Sanitary	100mm	PVC	-	-	2.50	-	December 1982
Water	20mm	Copper	-	-	-	-	December 1977
Storm	N/A	N/A	-	-	-	-	

Service Connection Location				Sanitary (m)	Storm (m)
Distance from downstream San MH	4298	towards upstream San MH	4366	23.04	
Distance from downstream Stm MH	-	towards upstream Stm MH	-		

Power	Size	Communications	Size	Cable	Size	Gas	Size
BC Hydro	-	Telus	-	Shaw	-	FortisBC	-
Overhead Service		Overhead Service		Overhead Service			

Installed by:	Survey Date:	-
Comments:		

NOT TO SCALE The information contained herein is for internal use only.
Not to be relied on unless confirmed by site inspection and/or investigation.

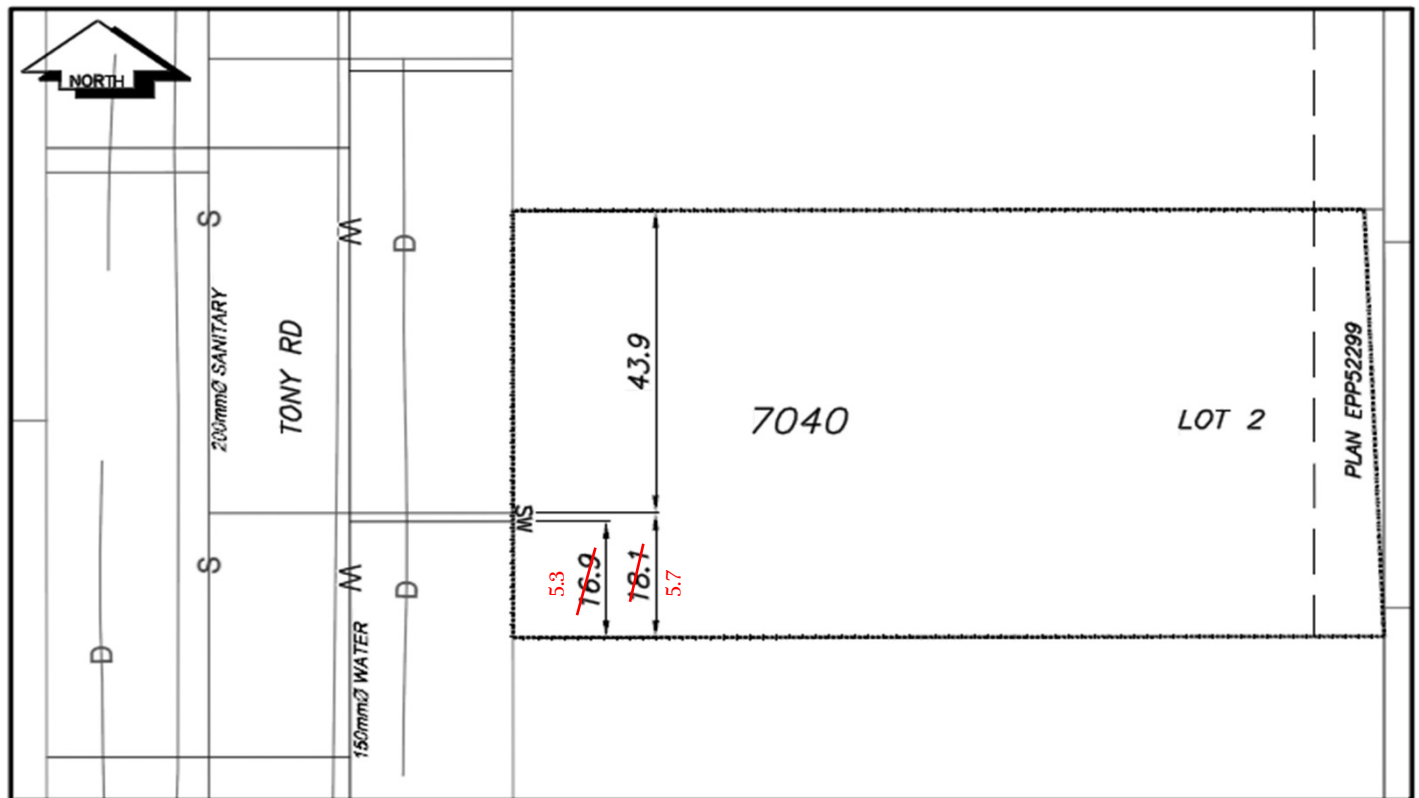

CS ^o CURB STOP	M WATER SERVICE	D STORM SERVICE
CO ^o CLEAN OUT	S SANITARY SERVICE	G GAS
⊗ WATER VALVE	⊗ FIRE HYDRANT	--- ENCUMBRANCE

NOT TO SCALE