



City of Prince George
History Sheet

| | |
|--------|-----------|
| PID: | 030725682 |
| SD/MU: | |
| WO: | |

Civic Address: 469 Nicholson St

Legal Description: Lot: PCL A Block: 48 District Lot: 937 Plan: 752


| Service Type | Diameter (mm) | Material | Invert Elev at main (m) | Invert Elev at property line (m) | Invert Depth at service end (m) | Distance into property (m) | Installation Date |
|--------------|---------------|----------|-------------------------|----------------------------------|---------------------------------|----------------------------|-------------------|
| Sanitary | 100mm | AC | - | 601.99 | 1.60 | - | December 1961 |
| Water | 20mm | Copper | - | - | - | - | December 1961 |
| Storm | N/A | N/A | - | - | - | - | |

| Service Connection Location | | | | Sanitary (m) | Storm (m) |
|---------------------------------|------|-------------------------|------|--------------|-----------|
| Distance from downstream San MH | 2581 | towards upstream San MH | 1701 | 73.85 | |
| Distance from downstream Stm MH | - | towards upstream Stm MH | - | | |

| Power | Size | Communications | Size | Cable | Size | Gas | Size |
|------------------|------|------------------|------|------------------|------|----------|------|
| BC Hydro | - | Telus | - | Shaw | - | FortisBC | - |
| Overhead Service | | Overhead Service | | Overhead Service | | | |

| | | |
|---------------|--------------|---|
| Installed by: | Survey Date: | - |
| Comments: | | |
| | | |
| | | |

NOT TO SCALE The information contained herein is for internal use only.
Not to be relied on unless confirmed by site inspection and/or investigation.

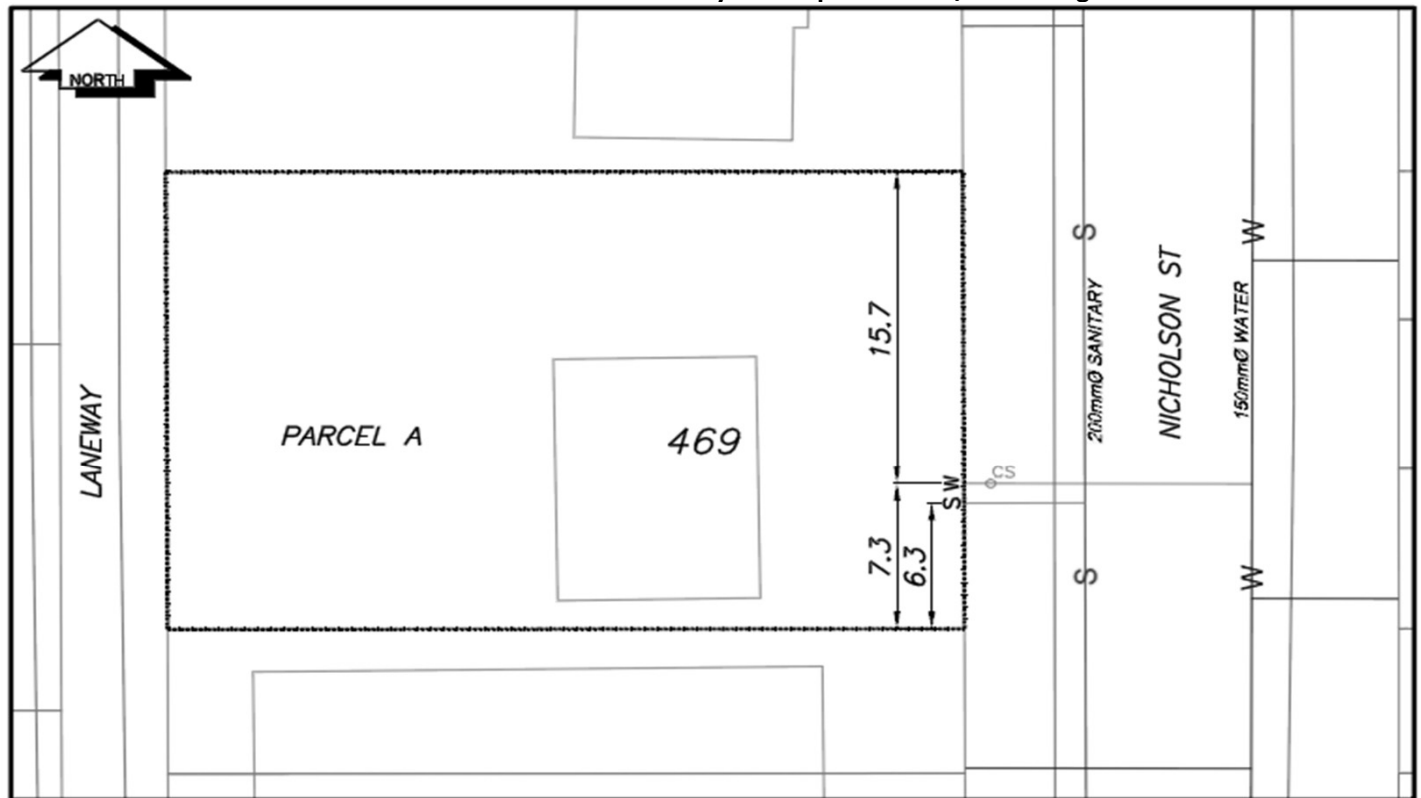

| | | |
|---------------|----------------------------|-----------------------|
| CS° CURB STOP | — W — WATER SERVICE | — S — STORM SERVICE |
| CO° CLEAN OUT | - - - S - SANITARY SERVICE | — G — GAS |
| ⊗ WATER VALVE | — ⊕ — FIRE HYDRANT | - - - - - ENCUMBRANCE |

NOT TO SCALE