



City of Prince George History Sheet

PID:	030727863
SD:	100329
WO:	

Civic Address: 1826 Boundary Rd

Legal Description: Lot: 1 District Lot: 629 Plan: EPP79589


Service Type	Diameter (mm)	Material	Invert Elev at main (m)	Invert Elev at property line (m)	Invert Depth at service end (m)	Distance into property (m)	Installation Date
Sanitary	150mm	AC	680.92	681.15	2.97	3.00	June 1977
Water	25mm	Copper	-	-	-	1.40	January 1977
Storm	N/A	N/A	-	-	-	-	

Service Connection Location	Sanitary (m)	Storm (m)
150mm Sanitary service connected to SMH on Boeing Rd	-	
Distance from downstream Stm MH - towards upstream Stm MH -		

Power	Size	Communications	Size	Cable	Size	Gas	Size
BC Hydro	-	Telus	-	Shaw	-	FortisBC	-
Overhead Service		Overhead Service		Overhead Service			

Installed by:	Survey Date:	-
Comments:		

NOT TO SCALE The information contained herein is for internal use only.
Not to be relied on unless confirmed by site inspection and/or investigation.

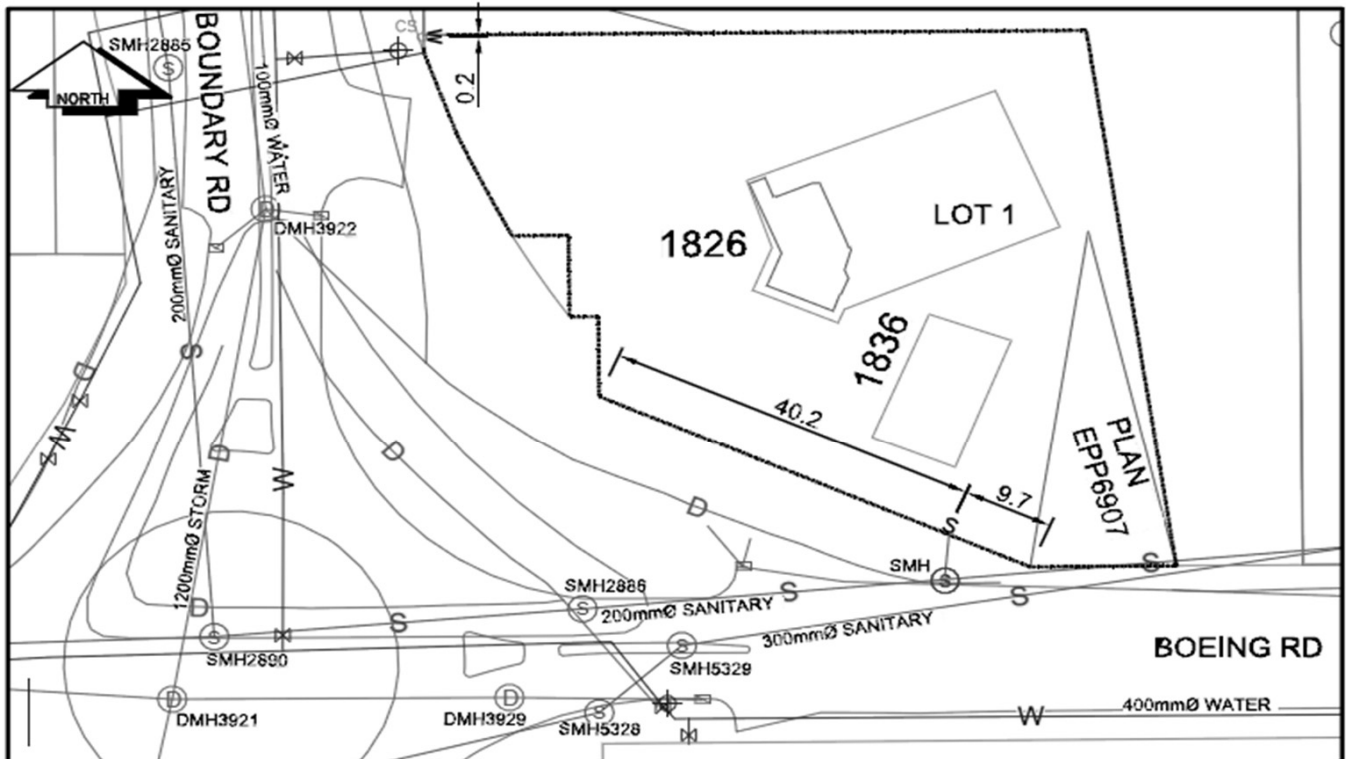

CS CURB STOP	WATER SERVICE	STORM SERVICE
CO CLEAN OUT	SANITARY SERVICE	GAS
WATER VALVE	FIRE HYDRANT	ENCUMBRANCE

NOT TO SCALE