



City of Prince George History Sheet

PID:	030745292
MU:	MU102008
WO:	97278/97280
	97279

Civic Address: 3314 Underhill Rd

Legal Description: Lot: A District Lot: 1433 Plan: EPP82200


Service Type	Diameter (mm)	Material	Invert Elev at main (m)	Invert Elev at property line (m)	Invert Elev at service end (m)	Distance into property (m)	Installation Date
Sanitary	100mm	PVC	590.53	591.17	591.15	2.20	September 2018
Water	20mm	Copper	590.81	591.14	591.22	2.20	September 2018
Storm	100mm	PVC	590.49	591.14	591.31	2.20	September 2018

Service Connection Location	Sanitary (m)	Storm (m)
100mm Sanitary service connected to San MH1862	-	
100mm Storm service connected to Stm MH1607		

Power	Size	Communications	Size	Cable	Size	Gas	Size
BC Hydro	-	Telus	-	Shaw	-	FortisBC	-
Overhead Service		Overhead Service		Overhead Service			

Installed by:	Survey Date:	-
Comments:		

NOT TO SCALE The information contained herein is for internal use only.
Not to be relied on unless confirmed by site inspection and/or investigation.

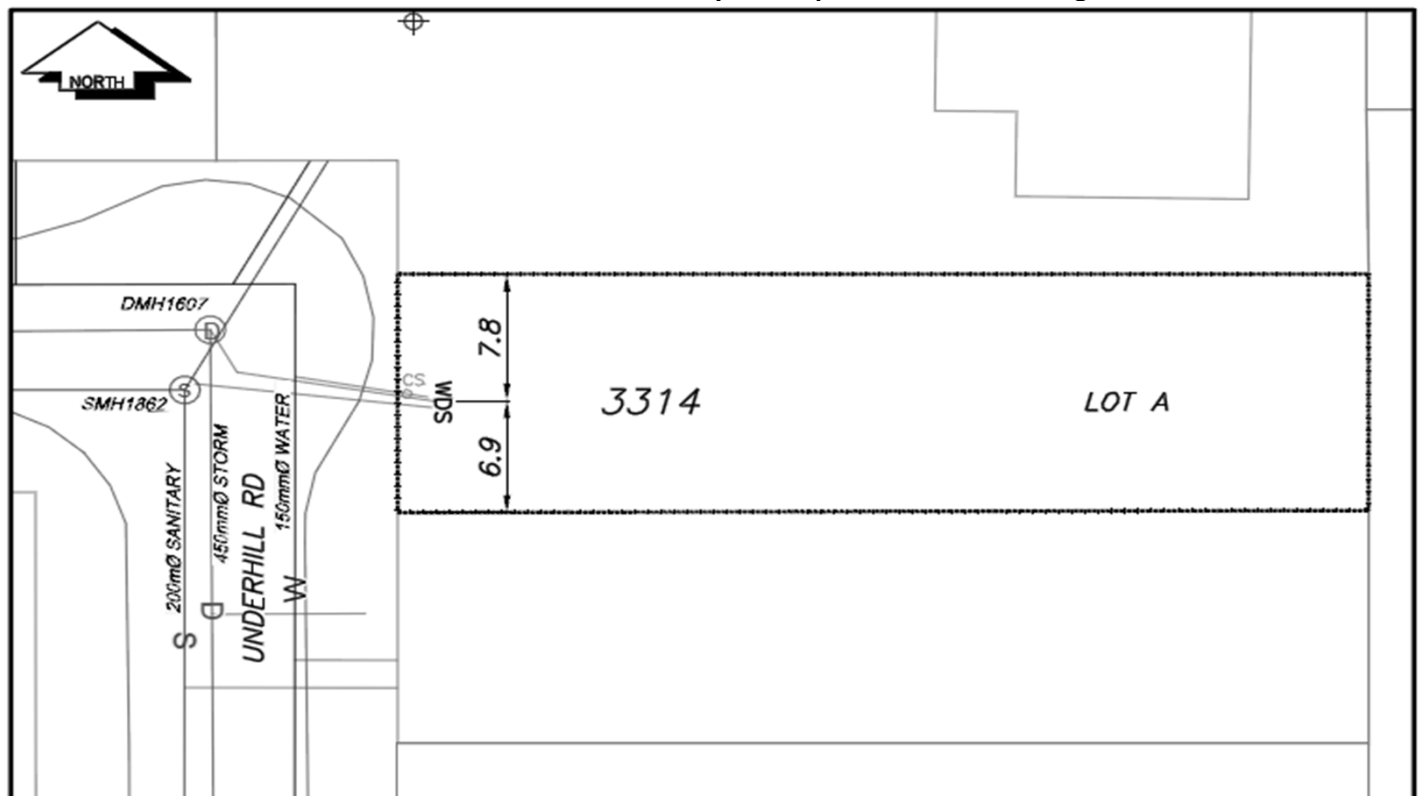

CS CURB STOP	W WATER SERVICE	D STORM SERVICE
CO CLEAN OUT	S SANITARY SERVICE	G GAS
WATER VALVE	FIRE HYDRANT	ENCUMBERANCE

NOT TO SCALE