



City of Prince George
History Sheet

PID:	030745306
MU:	102008
WO:	97279

Civic Address: 3326 Underhill Rd

Legal Description: Lot: B District Lot: 1433 Plan: EPP82200


Service Type	Diameter (mm)	Material	Invert Elev at main (m)	Invert Elev at property line (m)	Invert Depth at service end (m)	Distance into property (m)	Installation Date
Sanitary	100mm	PVC	-	-	2.86	-	December 1979
Water	20mm	Copper	-	-	-	-	December 1979
Storm	100mm	PVC	588.97	590.99	590.99	-	September 2018

Service Connection Location				Sanitary (m)	Storm (m)
Distance from downstream San MH	4088	towards upstream San MH	1862	111.20	
Distance from downstream Stm MH	1610	towards upstream Stm MH	1607		104.02

Power	Size	Communications	Size	Cable	Size	Gas	Size
BC Hydro	-	Telus	-	Shaw	-	FortisBC	-
Overhead Service		Overhead Service		Overhead Service			

Installed by:	City of Prince George forces	Survey Date:	-
Comments:			

NOT TO SCALE The information contained herein is for internal use only.
Not to be relied on unless confirmed by site inspection and/or investigation.

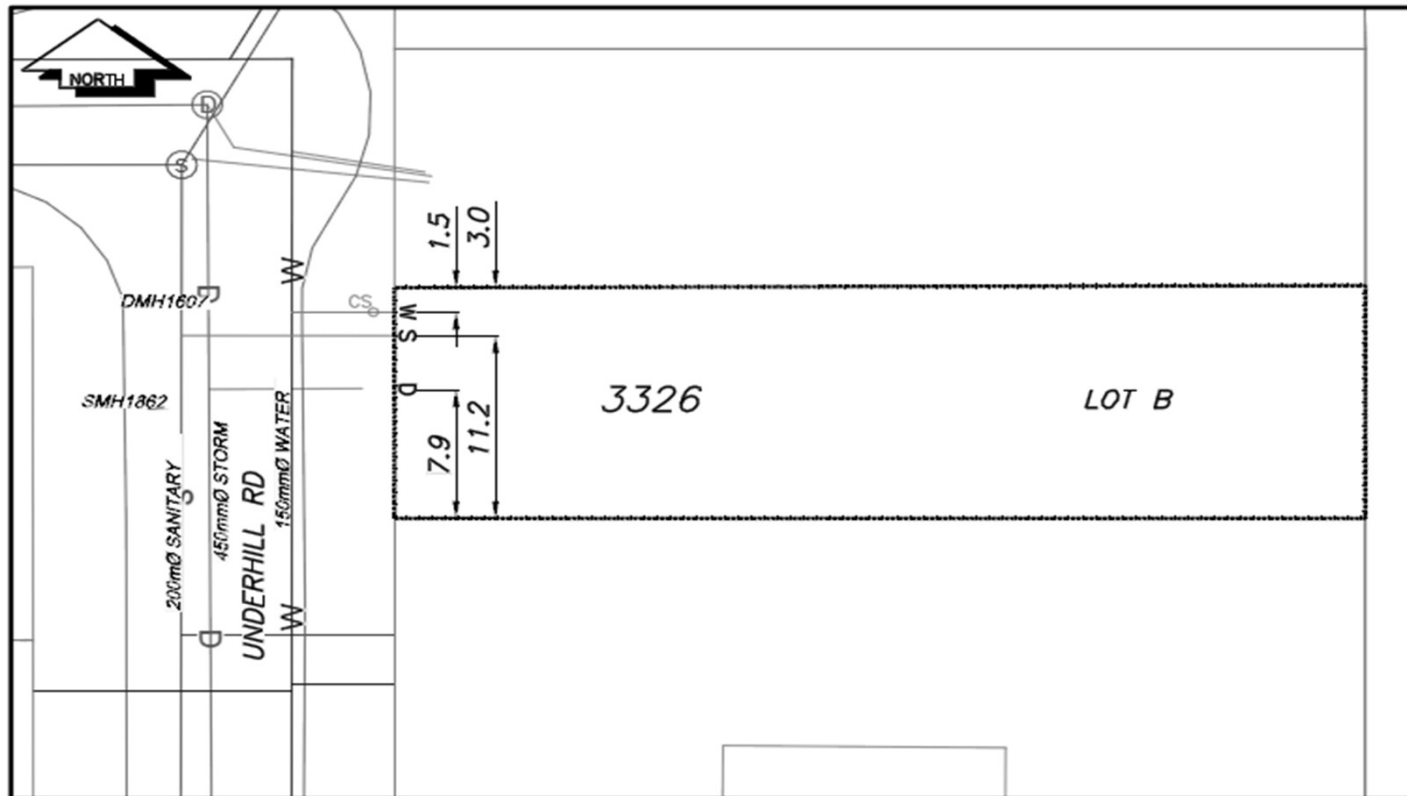

CS	CURB STOP	W	WATER SERVICE	○	STORM SERVICE
CO	CLEAN OUT	S	SANITARY SERVICE	G	GAS
⊗	WATER VALVE	⊗	FIRE HYDRANT	- - - -	ENCUMBRANCE

NOT TO SCALE