



City of Prince George History Sheet

PID:	030755034
MU:	101774
WO:	89434/89444

Civic Address: 6580 Dawson Rd

Legal Description: Lot: 5 District Lot: 4028 Plan: EPP66495


Service Type	Diameter (mm)	Material	Invert Elev at main (m)	Invert Elev at property line (m)	Invert Elev at service end (m)	Distance into property (m)	Installation Date
Sanitary	100mm	PVC	726.02	728.94	729.03	2.20	September 2016
Water	20mm	Copper	729.10	728.90	729.06	2.20	September 2016
Storm	N/A	N/A	-	-	-	-	

Service Connection Location				Sanitary (m)	Storm (m)
Distance from downstream San MH	404	towards upstream San MH	371	36.30	
Distance from downstream Stm MH	-	towards upstream Stm MH	-		

Power	Size	Communications	Size	Cable	Size	Gas	Size
BC Hydro	-	Telus	-	Shaw	-	FortisBC	-
Overhead Service		Overhead Service		Overhead Service			

Installed by:	City of Prince George forces	Survey Date:	-
Comments:			

NOT TO SCALE The information contained herein is for internal use only.
Not to be relied on unless confirmed by site inspection and/or investigation.

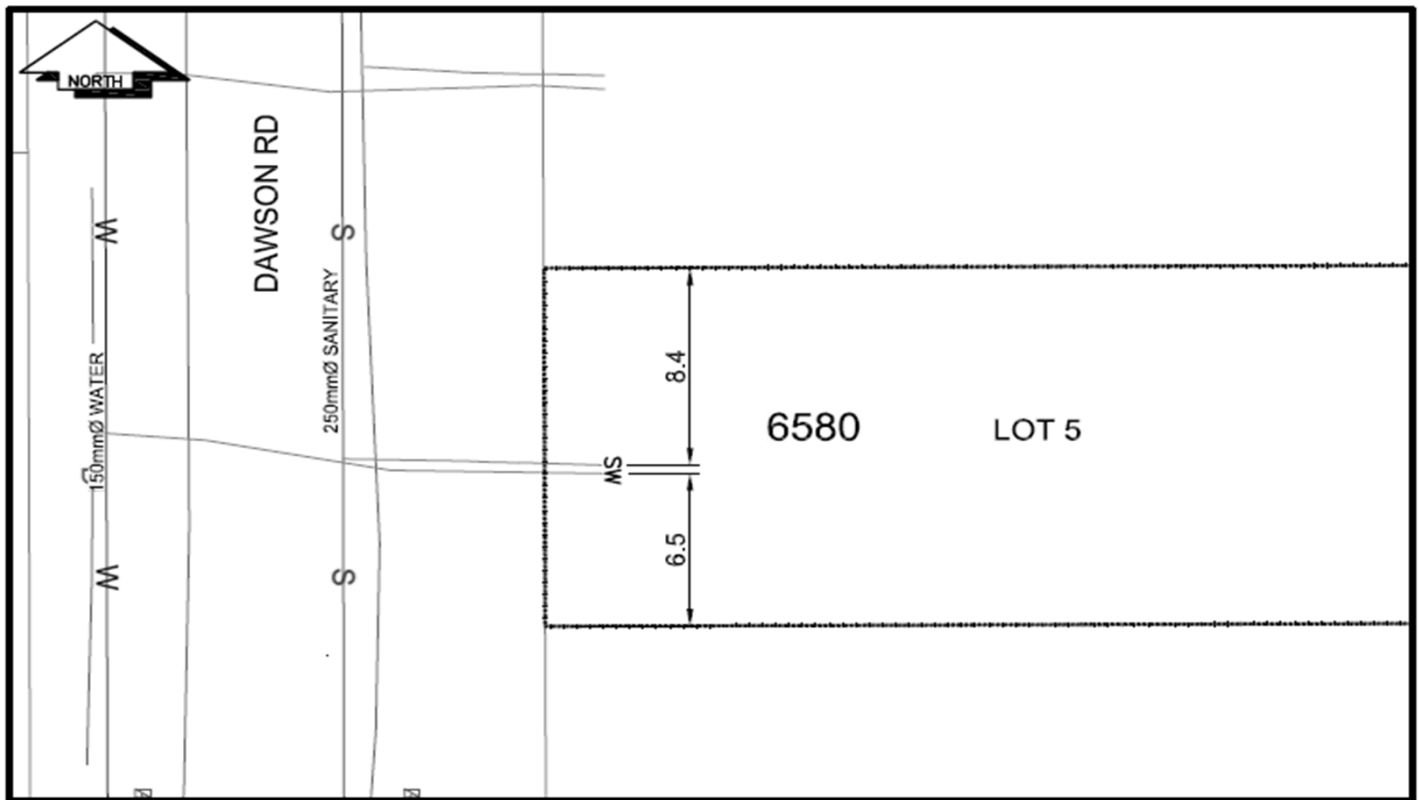

CS ^o CURB STOP	— M — WATER SERVICE	— S — STORM SERVICE
CO ^o CLEAN OUT	- - - S - SANITARY SERVICE	— G — GAS
⊗ WATER VALVE	⊗ FIRE HYDRANT	- - - - - ENCUMBRANCE

NOT TO SCALE