



City of Prince George History Sheet

PID:	030775736
SD/MU:	
WO:	

Civic Address: 745, 795 4th Ave

Legal Description: Lot: B District Lot: 343 Plan: EPP81514


Service Type	Diameter (mm)	Material	Invert Elev at main (m)	Invert Elev at property line (m)	Invert Elev at service end (m)	Distance into property (m)	Installation Date
Sanitary (S1)	Unknown	AC	-	-	-	-	December 1956
Sanitary (S2)	100mm	AC	-	-	-	-	December 1956
Water (W1)	25mm	Copper	-	-	-	-	December 1956
Water (W2)	20mm	Copper	-	-	-	-	December 1956
Storm (D1)	200mm	AC	-	-	-	-	December 1962
Storm (D2)	Unknown	AC	-	-	-	-	December 1962

Service Connection Location				Sanitary (m)	Storm (m)
Distance from downstream San MH	625	towards upstream San MH	2875	32.61	
200mm Storm service connected to Stm Mh3147					
Distance from downstream Stm MH	3385	towards upstream Stm MH	3013		35.10

Power	Size	Communications	Size	Cable	Size	Gas	Size
BC Hydro	-	Telus	-	Shaw	-	FortisBC	-
Overhead Service		Overhead Service		Overhead Service			

Installed by:	Survey Date:	-
Comments:		

NOT TO SCALE The information contained herein is for internal use only.
Not to be relied on unless confirmed by site inspection and/or investigation.

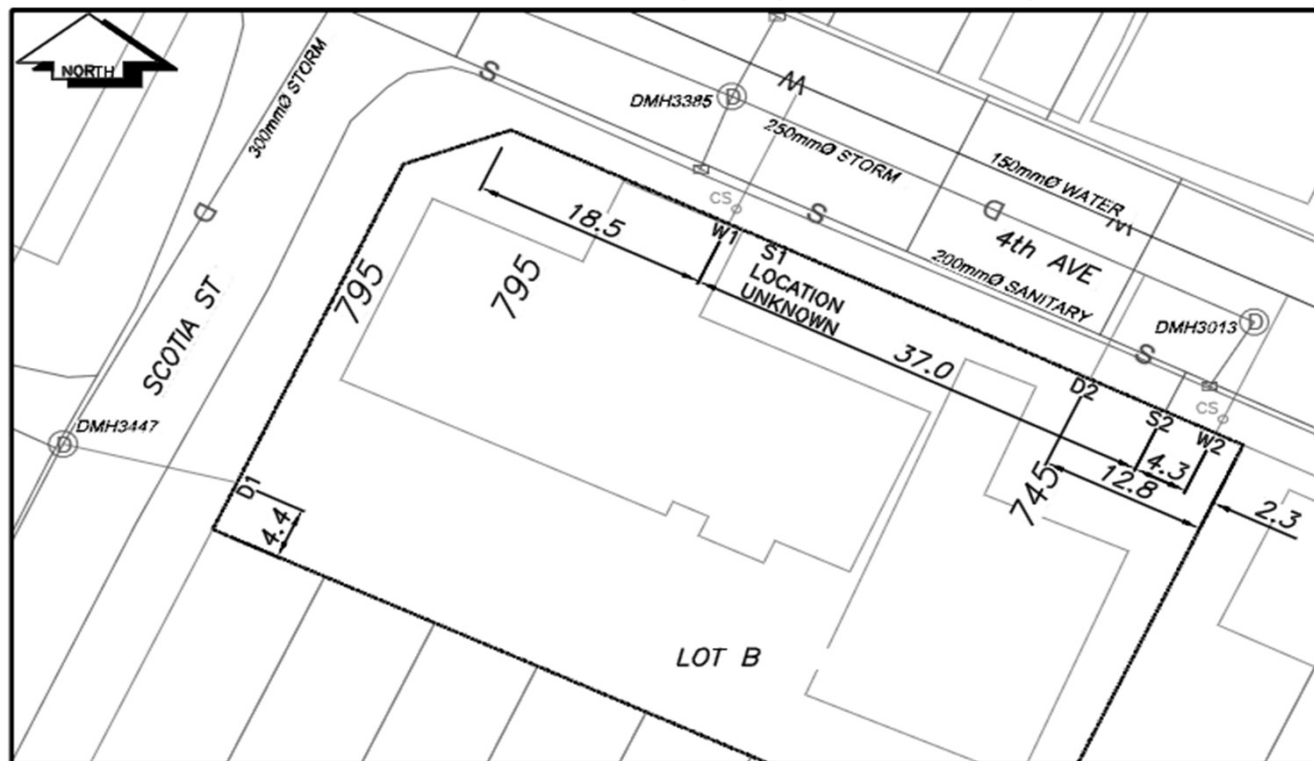

CS CURB STOP	W WATER SERVICE	S STORM SERVICE
CO CLEAN OUT	S SANITARY SERVICE	G GAS
W VALVE	F FIRE HYDRANT	E ENCUMBRANCE

NOT TO SCALE