



City of Prince George
History Sheet

PID:	030789443
MU:	102024
WO:	

Civic Address: 1253 Blackburn Rd

Legal Description: Lot: 1 District Lot: 632 Plan: EPP68929


Service Type	Diameter (mm)	Material	Invert Elev at main (m)	Invert Elev at property line (m)	Invert Elev at service end (m)	Distance into property (m)	Installation Date
Sanitary	100mm	PVC	-	-	-	-	August 2018
Water	20mm	Copper	-	-	-	-	August 2018
Storm	N/A	N/A	-	-	-	-	

Service Connection Location				Sanitary (m)	Storm (m)
Distance from downstream San MH	4019	towards upstream San MH	4018	34.79	
Distance from downstream Stm MH	-	towards upstream Stm MH	-		

Power	Size	Communications	Size	Cable	Size	Gas	Size
BC Hydro	-	Telus	-	Shaw	-	FortisBC	-
Overhead Service		Overhead Service		Overhead Service			

Installed by:	City of Prince George forces	Survey Date:	-
Comments:			

NOT TO SCALE The information contained herein is for internal use only.
Not to be relied on unless confirmed by site inspection and/or investigation.

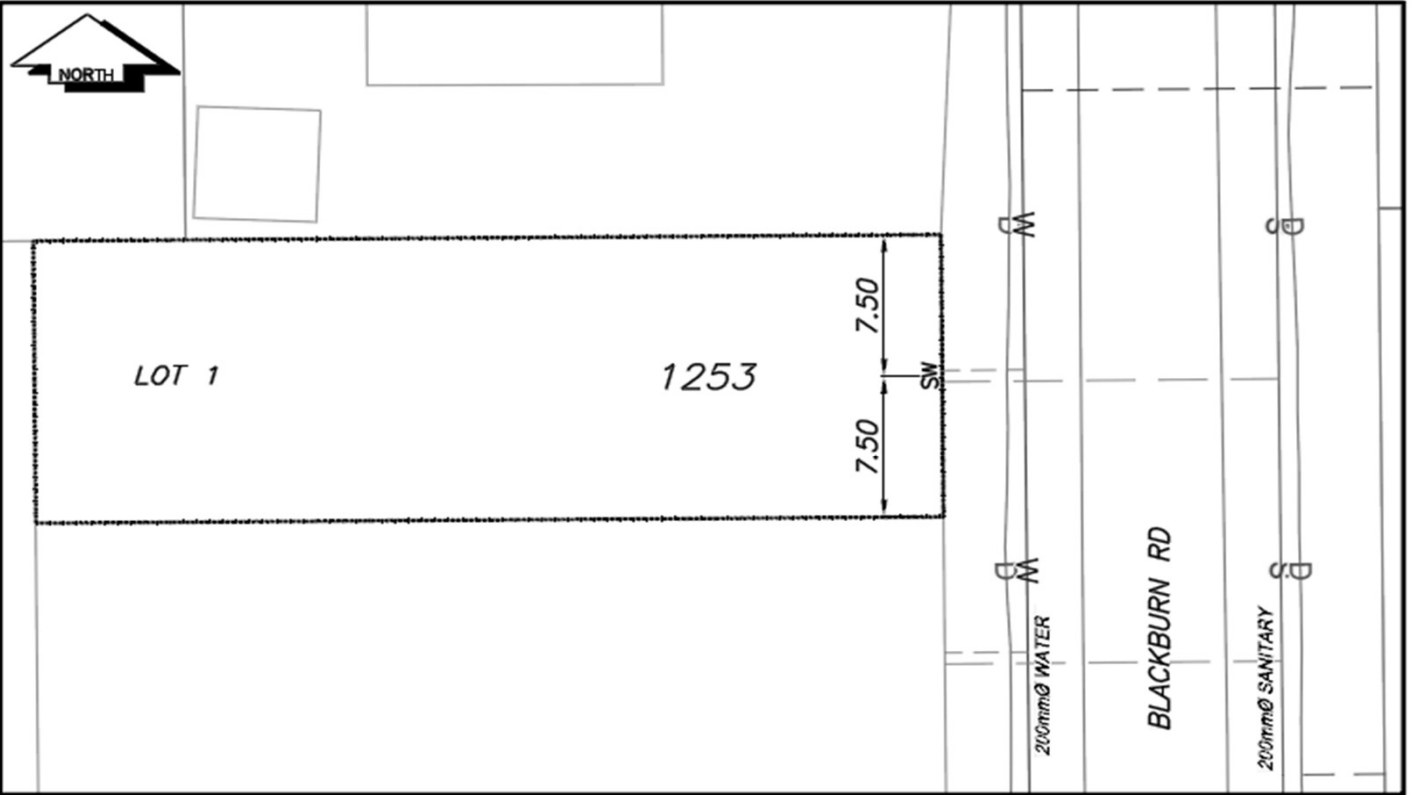

LEGEND:	CS CURB STOP	--- WATER SERVICE	--- STORM SERVICE
	CO CLEAN OUT	--- SANITARY SERVICE	--- GAS
	WATER VALVE	--- FIRE HYDRANT	--- ENCUMBRANCE

NOT TO SCALE