



CITY OF
PRINCE GEORGE

City of Prince George HISTORY SHEET

PID:	030-813-743
SD/MU:	SD100537
WO:	

CIVIC ADDRESS: 7073 HILLU ROAD


LEGAL DESCRIPTION: LOT 9 DISTRICT LOT 2424 PLAN EPP86274

SERVICE TYPE	DIAMETER (mm)	MATERIAL	INVERT ELEV AT MAIN (m)	INVERT ELEV AT PROPERTY LINE (m)	INVERT ELEV AT SERVICE END (m)	COVER AT PROPERTY LINE (m)	DISTANCE INTO PROPERTY (m)	INSTALLATION DATE
SANITARY	100	PVC	755.58	756.21	756.28	2.19	3.00	NOV 2018
WATER	19	COPPER	755.28	755.80	755.98	2.62	3.00	NOV 2018
STORM	N/A	N/A	N/A	N/A	N/A	N/A	N/A	N/A

ELECTRICAL / COMMUNICATIONS / GAS			
TYPE	PROVIDER	SIZE AND MATERIAL	LOCATION (UNDERGROUND/ OVERHEAD)
ELECTRICAL	BC HYDRO	75mm DB2	OVERHEAD
COMMUNICATION	TELUS	50mm DB2	OVERHEAD
COMMUNICATION	SHAW	50mm DB2	OVERHEAD
GAS	FORTISBC	42 PROP/P.E.	OVERHEAD

INFORMATION SHEETS: L&M ENGINEERING LIMITED PROJECT NUMBER 1582-01	SURVEY DATE: NOV 2018
INSTALLED BY: NBC CONTRACTING INC.	
COMMENTS:	

THE INFORMATION CONTAINED HEREIN IS FOR INTERNAL USE ONLY.
NOT TO BE RELIED UPON UNLESS CONFIRMED BY SITE INVESTIGATION.

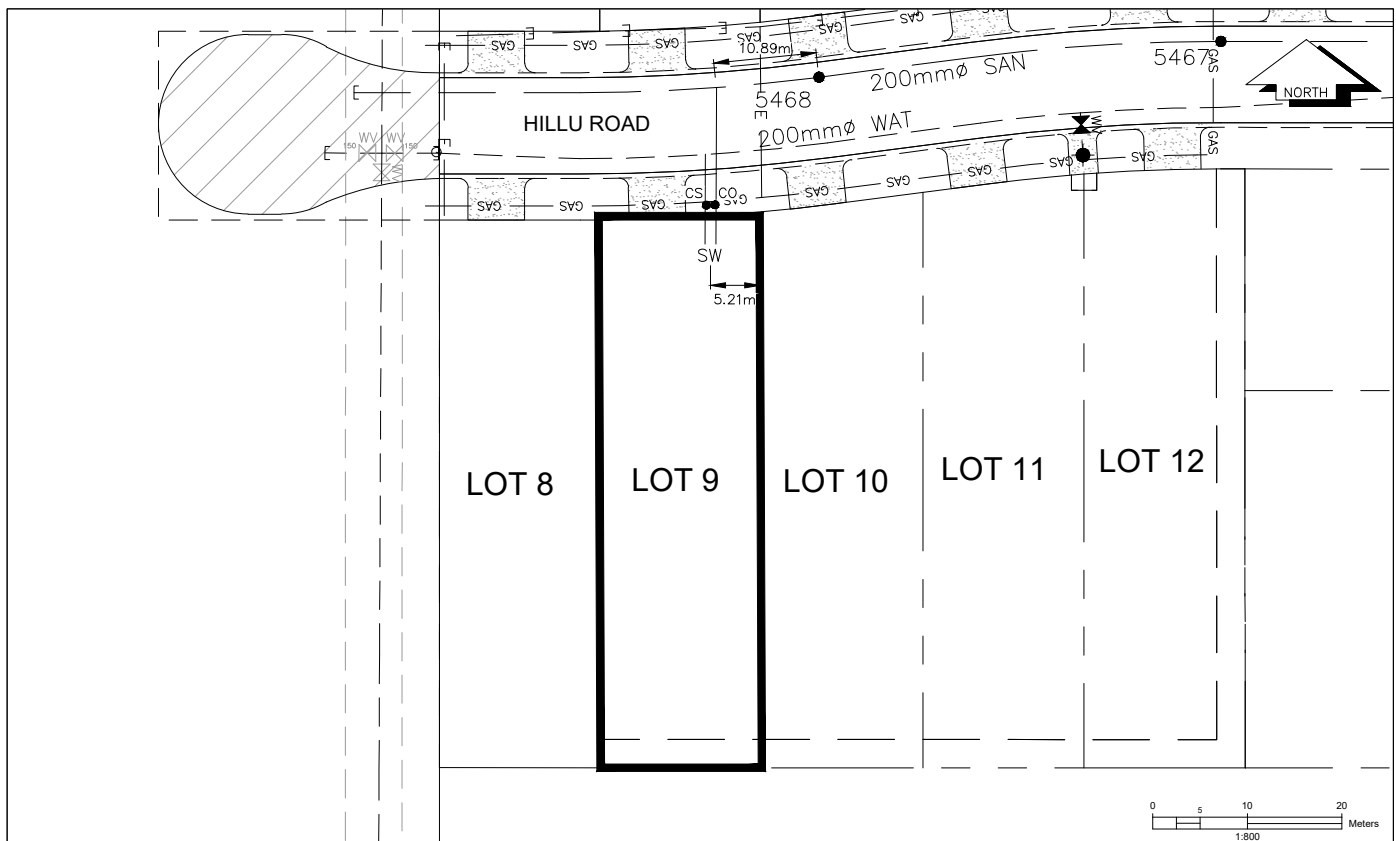

LEGEND:	CS CURB STOP	— W WATER SERVICE	— H HYDRO SERVICE	— GAS GAS
	CO CLEAN OUT	— S STORM SERVICE	— T TELECOMMUNICATIONS	— E ELECTRICAL
		— SANITARY SERVICE		