



City of Prince George History Sheet

PID:	030839131
SD/MU:	
WO:	

Civic Address: 1691 4th Ave

Legal Description: Lot: PCL C Block: 155 District Lot: 343 Plan: 1268 (CA7603376)


Service Type	Diameter (mm)	Material	Invert Elev at main (m)	Invert Elev at property line (m)	Invert Depth at service end (m)	Distance into property (m)	Installation Date
Sanitary	100mm	AC	-	576.15	2.04	-	December 1955
Water	13mm	Copper	-	-	-	-	December 1956
Storm	N/A	N/A	-	-	-	-	

Service Connection Location				Sanitary (m)	Storm (m)
Distance from downstream San MH	1997	towards upstream San MH	1905	93.13	
Distance from downstream Stm MH	-	towards upstream Stm MH	-		

Power	Size	Communications	Size	Cable	Size	Gas	Size
BC Hydro	-	Telus	-	Shaw	-	FortisBC	-
Overhead Service		Overhead Service		Overhead Service			

Installed by:	Survey Date:	-
Comments:		

NOT TO SCALE The information contained herein is for internal use only.
Not to be relied on unless confirmed by site inspection and/or investigation.

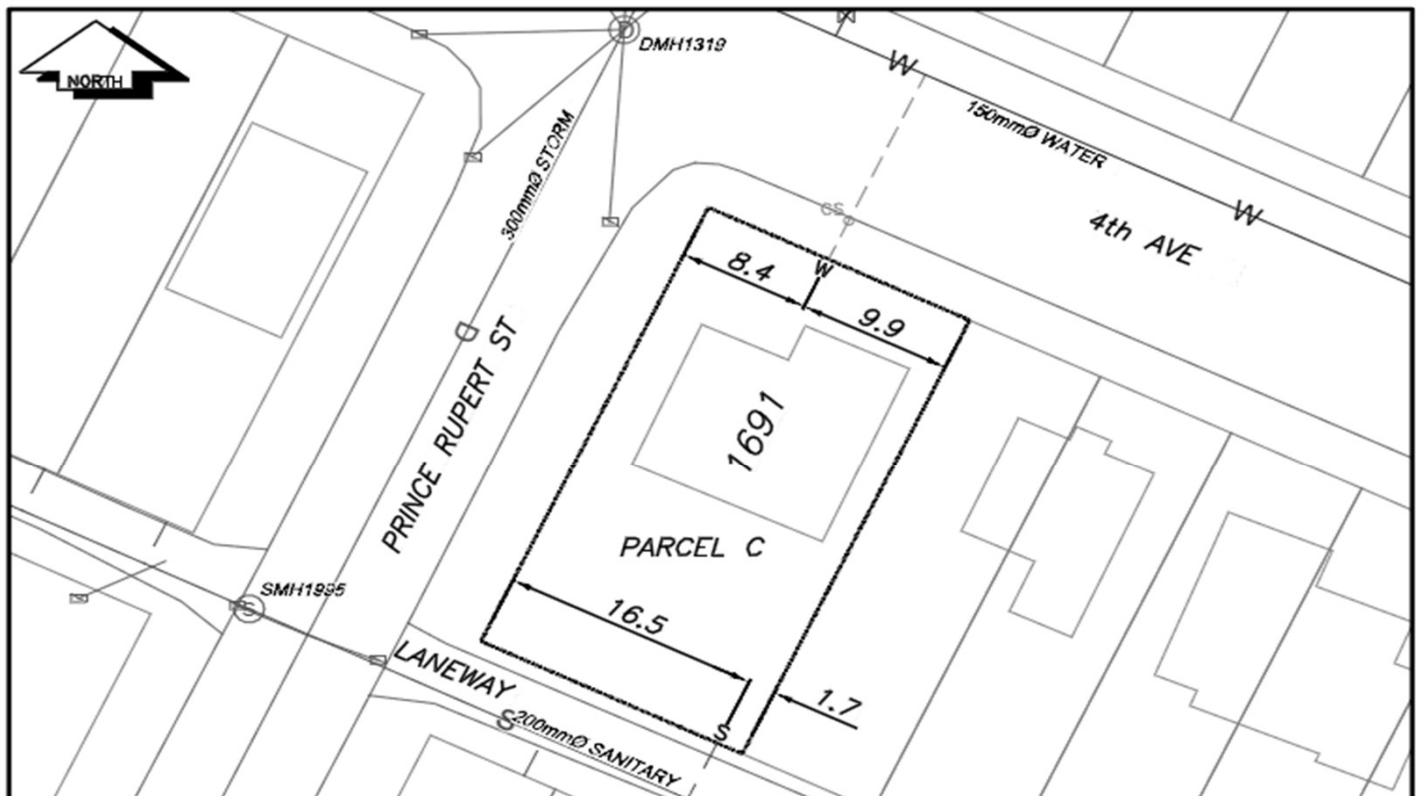

CS CURB STOP	--- W WATER SERVICE	--- S STORM SERVICE
CO CLEAN OUT	--- S SANITARY SERVICE	--- G GAS
WATER VALVE	--- F FIRE HYDRANT	--- ENCUMBRANCE

NOT TO SCALE