



City of Prince George  
**History Sheet**

PID:	030857180
SD/MU:	
WO:	

Civic Address: 2727, 2729 Moyie St

Legal Description: Lot: PCL B (CA7651505 Block: 23 District Lot: 933 Plan: 727


Service Type	Diameter (mm)	Material	Invert Elev at main (m)	Invert Elev at property line (m)	Invert Depth at service end (m)	Distance into property (m)	Installation Date
Sanitary	100mm	AC	-	-	2.10	-	December 1970
Water	20mm	Copper	-	-	-	-	December 1954
Storm	N/A	N/A	-	-	-	-	

Service Connection Location				Sanitary (m)	Storm (m)
Distance from downstream San MH	3529	towards upstream San MH	3528	37.45	
Distance from downstream Stm MH	-	towards upstream Stm MH	-		

Power	Size	Communications	Size	Cable	Size	Gas	Size
BC Hydro	-	Telus	-	Shaw	-	FortisBC	-
Overhead Service		Overhead Service		Overhead Service			

Installed by:	Survey Date:	-
Comments:		

**NOT TO SCALE** The information contained herein is for internal use only.  
Not to be relied on unless confirmed by site inspection and/or investigation.

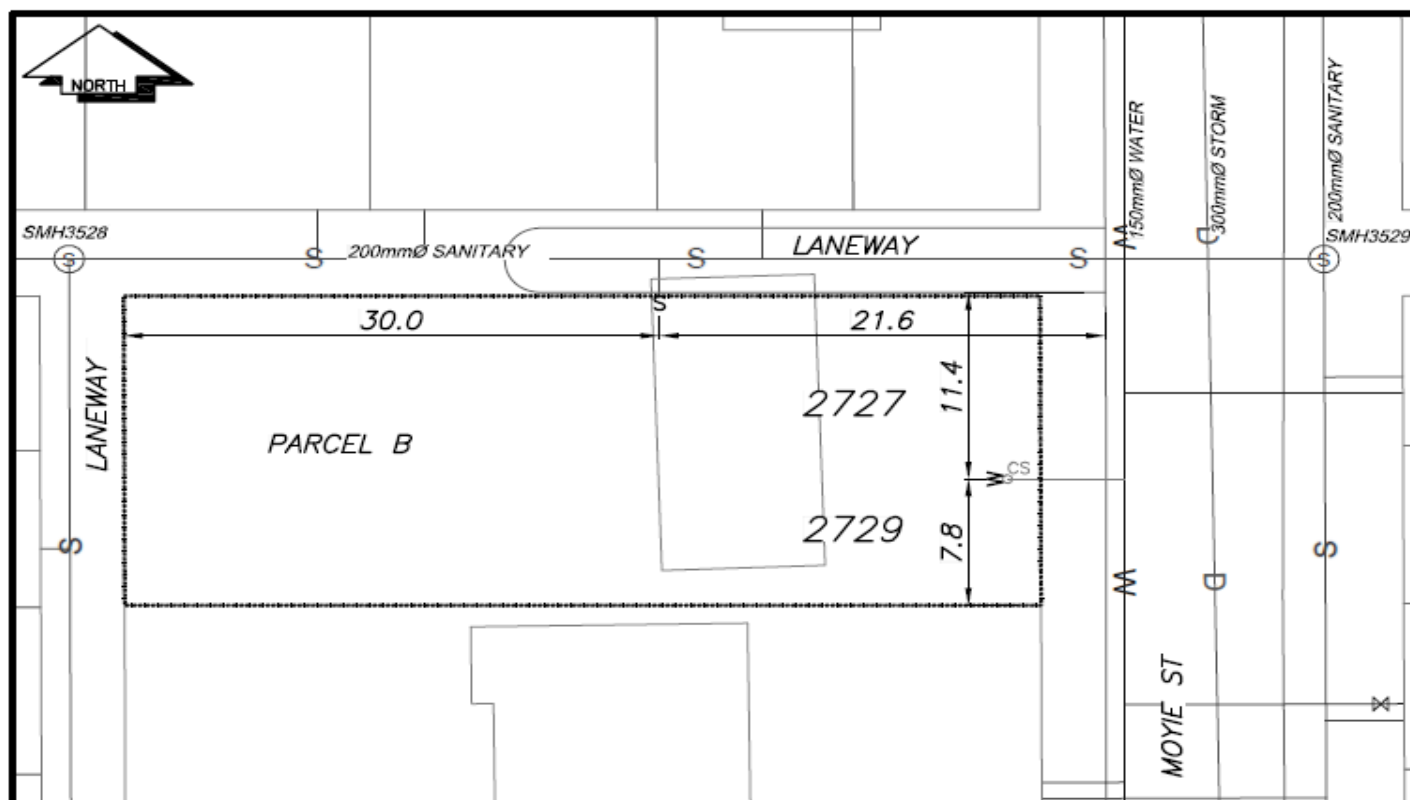

CS <sup>o</sup> CURB STOP	—W— WATER SERVICE	—S— STORM SERVICE
CO <sup>o</sup> CLEAN OUT	---S--- SANITARY SERVICE	—G— GAS
WATER VALVE	—X— FIRE HYDRANT	--- ENCUMBRANCE

**NOT TO SCALE**