



# City of Prince George History Sheet

PID:	030875536
MU:	101866
WO:	100587/100591

Civic Address: 4797 Handlen Rd

Legal Description: Lot: A District Lot: 4048 Plan: EPP86827


Service Type	Diameter (mm)	Material	Invert Elev at main (m)	Invert Elev at property line (m)	Invert Elev at service end (m)	Distance into property (m)	Installation Date
Sanitary	100mm	AC	-	-	-	-	December 1978
Water	20mm	Copper	767.86	762.21	762.24	-	August 2019
Storm	100mm	PVC	761.42	762.19	-	-	August 2019

Service Connection Location	Sanitary (m)	Storm (m)
100mm Sanitary service connected to San MH215	-	
Distance from downstream Stm MH - towards upstream Stm MH -		

Power	Size	Communications	Size	Cable	Size	Gas	Size
BC Hydro	-	Telus	-	Shaw	-	FortisBC	-
Overhead Service		Overhead Service		Overhead Service			

Installed by: City of Prince George forces	Survey Date: -
Comments:	

**NOT TO SCALE** The information contained herein is for internal use only.  
Not to be relied on unless confirmed by site inspection and/or investigation.

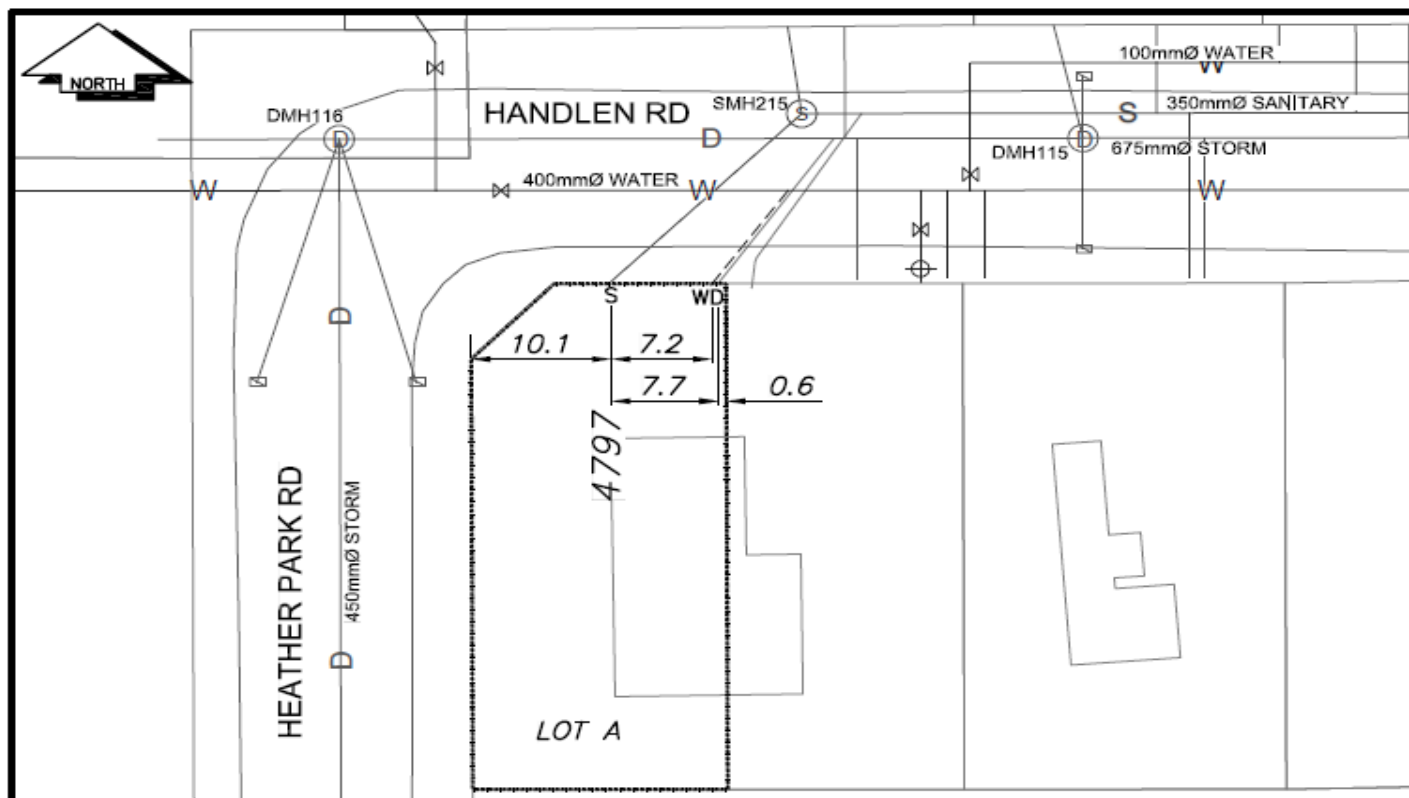

CS <sup>o</sup> CURB STOP	—W— WATER SERVICE	—D— STORM SERVICE
CO <sup>o</sup> CLEAN OUT	- - - - - S SANITARY SERVICE	—G— GAS
⊗ WATER VALVE	⊗ FIRE HYDRANT	- - - - - ENCUMBRANCE

**NOT TO SCALE**