



City of Prince George History Sheet

PID:	030877393
SD/MU:	
WO:	

Civic Address: 975 Brunswick St

Legal Description: Lot: PCL A (CA7693116) Block: 197 District Lot: 343 Plan: 1268


Service Type	Diameter (mm)	Material	Invert Elev at main (m)	Invert Elev at property line (m)	Invert Depth at service end (m)	Distance into property (m)	Installation Date
Sanitary	150mm	AC	567.00	567.43	1.71	-	December 1966
Water	150mm	CI	-	-	-	-	December 1958
Storm	150mm	AC	-	568.18	0.97	-	December 1970

Service Connection Location				Sanitary (m)	Storm (m)
Distance from downstream San MH	750	towards upstream San MH	751	27.74	
Distance from downstream Stm MH	3304	towards upstream Stm MH	3301		92.68

Power	Size	Communications	Size	Cable	Size	Gas	Size
BC Hydro	-	Telus	-	Shaw	-	FortisBC	-
Overhead Service		Overhead Service		Overhead Service			

Installed by:	Survey Date:	-
Comments:		

NOT TO SCALE The information contained herein is for internal use only.
Not to be relied on unless confirmed by site inspection and/or investigation.

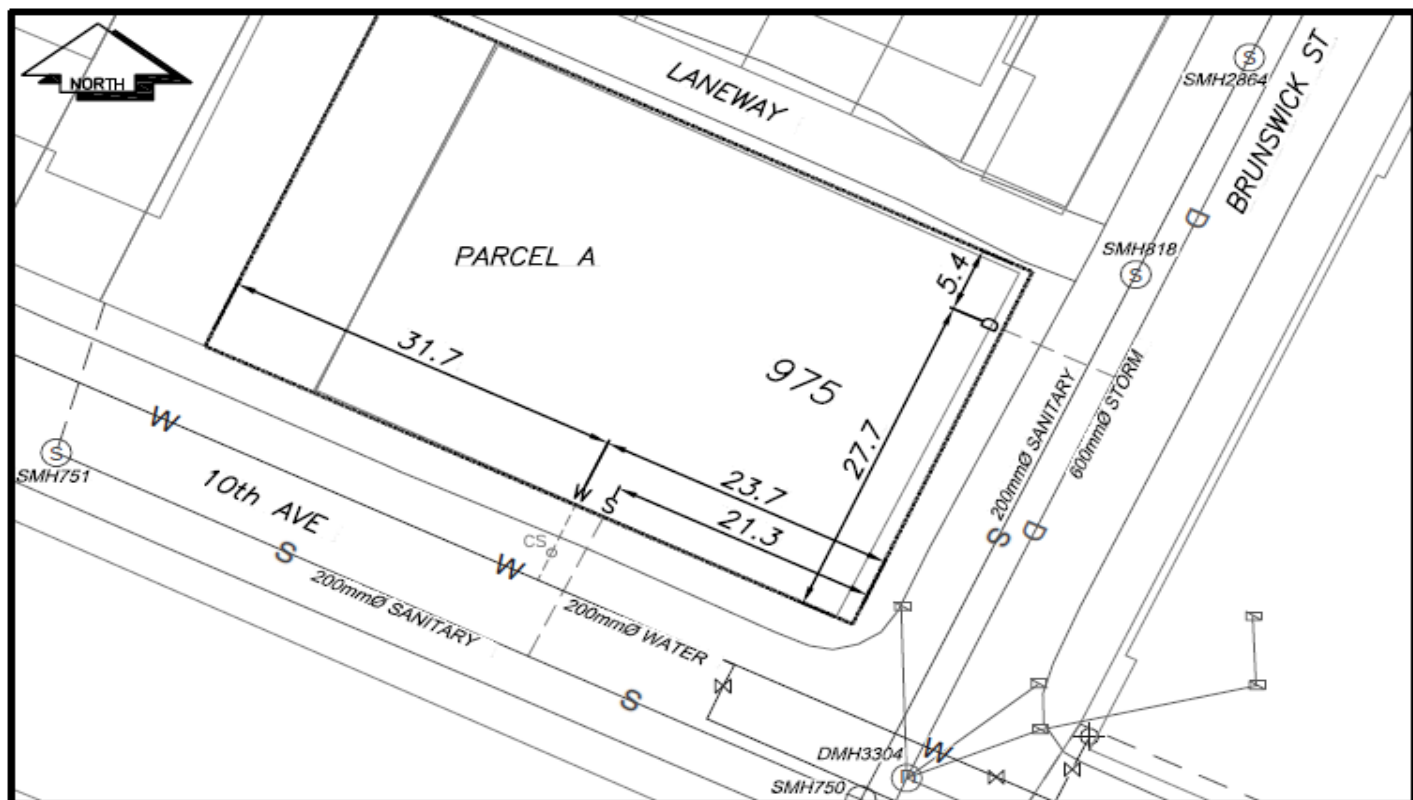

CS ^o CURB STOP	—S— WATER SERVICE	—G— STORM SERVICE
CO ^o CLEAN OUT	- - - - - SANITARY SERVICE	—G— GAS
⊗ WATER VALVE	⊗ FIRE HYDRANT	- - - - - ENCUMBRANCE

NOT TO SCALE