



The City of Prince George does not represent or guarantee that the information contained in this document is accurate or reliable, and any person who relies on this information in this document does so at their own risk.

City of Prince George

This information has been provided subject to the Federal Copyright Act and in accordance with the Provincial Freedom of Information and Protection of Privacy Act.

THE SEAL AND SIGNATURE OF THE UNDERSIGNED ON THIS DRAWING CERTIFIES THAT THE DESIGN INFORMATION CONTAINED IN THESE DRAWINGS ACCURATELY REFLECTS THE ORIGINAL DESIGN AND THE MATERIAL DESIGN CHANGES MADE DURING CONSTRUCTION, THAT WERE BROUGHT TO THE UNDERSIGNED'S ATTENTION. THESE DRAWINGS ARE INTENDED TO INCORPORATE ADDENDA, CHANGE ORDERS AND OTHER MATERIAL DESIGN CHANGES, BUT NOT NECESSARILY ALL SITE INSTRUCTIONS. THE UNDERSIGNED DOES NOT WARRANT OR GUARANTEE, NOR ACCEPT ANY RESPONSIBILITY FOR THE ACCURACY OR COMPLETENESS OF THE AS-CONSTRUCTED INFORMATION SUPPLIED BY OTHERS CONTAINED IN THESE DRAWINGS, BUT DOES, BY SEALING AND SIGNING, CERTIFY THAT THE AS-CONSTRUCTED INFORMATION, IF ACCURATE AND COMPLETE, PROVIDES AN AS-CONSTRUCTED SYSTEM WHICH SUBSTANTIALLY COMPLIES IN ALL MATERIAL RESPECTS WITH THE ORIGINAL DESIGN INTENT.

RECORD DRAWING

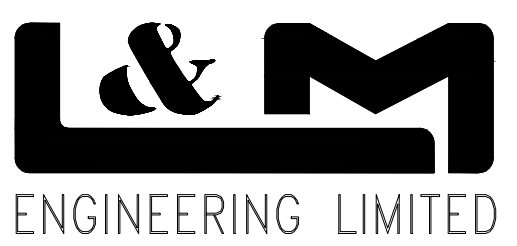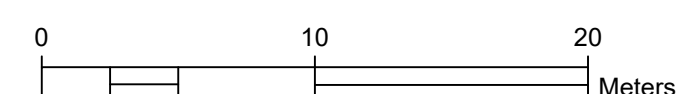

1210 FOURTH AVENUE
PRINCE GEORGE, B.C.
V2L 3J4
TEL (250) 562-1977
FAX (250) 562-1967



REVISIONS:

- 10 22-11-30 RECORD DRAWING
- 9 20-11-12 REV PER CITY COMMENTS
- 8 20-11-5 REV PER CITY COMMENTS
- 7 20-8-28 REV SAN MH INV & BLDG 2 & 3 INV
- 6 20-8-12 REV TRANSITION HOUSE FFE
- 5 20-6-25 ISSUED FOR CONSTRUCTION
- 4 20-6-5 REV RC & INFILTRATION
- 3 20-2-28 ISSUED FOR TENDER & BP

COPYRIGHT RESERVED:
THE COPYRIGHT TO THIS DRAWING AND ITS CONTENTS IS RESERVED AND REMAINS AT ALL TIMES THE EXCLUSIVE PROPERTY OF BONI-MADDISON ARCHITECTS, AND SHALL NOT BE USED, MODIFIED, OR REPRODUCED WITHOUT THE EXPRESSED WRITTEN CONSENT OF BONI-MADDISON ARCHITECTS.

DIMENSIONS:
THE CONTRACTOR SHALL VERIFY ALL DIMENSIONS, AND IMMEDIATELY REPORT ANY ERRORS AND/OR OMISSIONS. DO NOT SCALE DRAWINGS.


BONI • MADDISON
Architects

3732 West Broadway
Vancouver, B.C., V6R 2C1
T: 604 688 5894
F: 604 688 5899
E: info@bonimaddison.com

PROJECT:
E. FRY HOUSING PROJECT
2588 14TH AVE
PRINCE GEORGE BC

TITLE:
SERVICING PLAN

DRAWN: KP	DRAWING NO: C005
SCALE: 1:250	JOB NO: 1254-07
DATE: 25FEB2020	REV. NO: 8

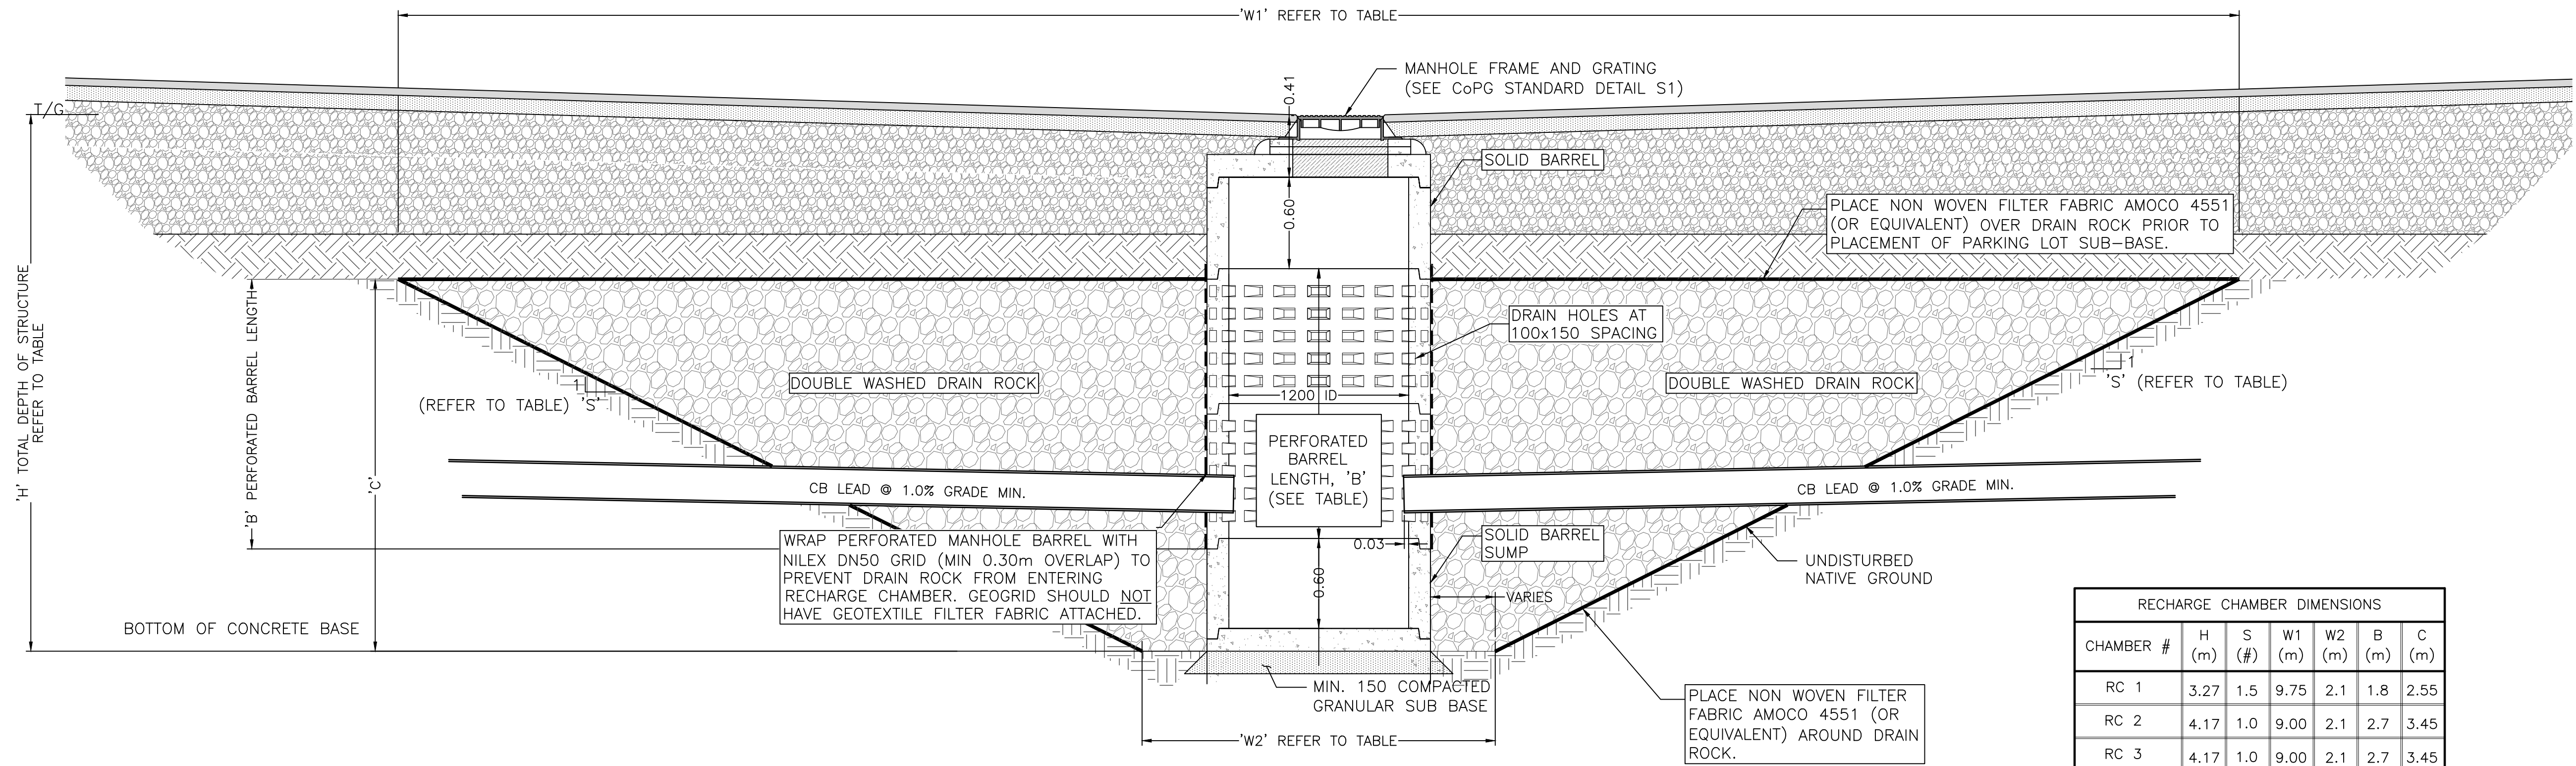

THE SEAL AND SIGNATURE OF THE UNDERSIGNED ON THIS DRAWING CERTIFIES THAT THE DESIGN INFORMATION CONTAINED IN THESE DRAWINGS ACCURATELY REFLECTS THE ORIGINAL DESIGN AND THE MATERIAL DESIGN CHANGES MADE DURING CONSTRUCTION, THAT WERE BROUGHT TO THE UNDERSIGNED'S ATTENTION. THESE DRAWINGS ARE INTENDED TO INCORPORATE ADDENDA, CHANGE ORDERS AND OTHER MATERIAL DESIGN CHANGES, BUT NOT NECESSARILY ALL SITE INSTRUCTIONS. THE UNDERSIGNED DOES NOT WARRANT OR GUARANTEE, NOR ACCEPT ANY RESPONSIBILITY FOR THE ACCURACY OR COMPLETENESS OF THE AS-CONSTRUCTED INFORMATION SUPPLIED BY OTHERS CONTAINED IN THESE DRAWINGS, BUT DOES, BY SEALING AND SIGNING, CERTIFY THAT THE AS-CONSTRUCTED INFORMATION, IF ACCURATE AND COMPLETE, PROVIDES AN AS-CONSTRUCTED SYSTEM WHICH SUBSTANTIALLY COMPLIES IN ALL MATERIAL RESPECTS WITH THE ORIGINAL DESIGN INTENT.

RECHARGE CHAMBER (RC1, RC2, RC3)
1:25

RECHARGE CHAMBER DIMENSIONS						
CHAMBER #	H (m)	S (#)	W1 (m)	W2 (m)	B (m)	C (m)
RC 1	3.27	1.5	9.75	2.1	1.8	2.55
RC 2	4.17	1.0	9.00	2.1	2.7	3.45
RC 3	4.17	1.0	9.00	2.1	2.7	3.45



1210 FOURTH AVENUE
PRINCE GEORGE, B.C.
V2L 3J4
TEL (250) 562-1977
FAX (250) 562-1967



REVISIONS:

- 7 22-11-30 RECORD DRAWING
- 6 20-11-2 REV PER CITY COMMENTS
- 5 20-6-25 ISSUED FOR CONSTRUCTION
- 4 20-6-5 REV RECHARGE CHAMBERS
- 3 20-2-28 ISSUED FOR TENDER & BP
- 2 19-8-9 ISSUED FOR BP
- 1 19-1-25 ISSUED FOR DP
- 0 18-11-21 FOR COORDINATION ISSUES.

COPYRIGHT RESERVED:
THE COPYRIGHT TO THIS DRAWING AND ITS CONTENTS IS RESERVED, AND REMAINS AT ALL TIMES THE EXCLUSIVE PROPERTY OF BONI-MADDISON ARCHITECTS, AND SHALL NOT BE USED, MODIFIED, OR REPRODUCED WITHOUT THE EXPRESSED WRITTEN CONSENT OF BONI-MADDISON ARCHITECTS.

DIMENSIONS:
THE CONTRACTOR SHALL VERIFY ALL DIMENSIONS, AND IMMEDIATELY REPORT ANY ERRORS AND/OR OMISSIONS. DO NOT SCALE DRAWINGS.

The City of Prince George does not represent or guarantee that the information contained in this document is accurate or reliable, and any person who relies on this information in this document does so at their own risk.

City of Prince George

This information has been provided subject to the Federal Copyright Act and in accordance with the Provincial Freedom of Information and Protection of Privacy Act.

BONI • MADDISON
Architects

3732 West Broadway
Vancouver, B.C., V6R 2C1
T: 604 688 5894
F: 604 688 5899
E: info@bonimaddison.com

PROJECT:
E.FRY HOUSING PROJECT
2588 14TH AVE
PRINCE GEORGE BC

TITLE:
CONSTRUCTION DETAILS

DRAWN: KP

SCALE: AS NOTED


JOB N°: 1254-07

DATE: 25FEB2020

DRAWING N°:

C009RD


REV. N°: 7

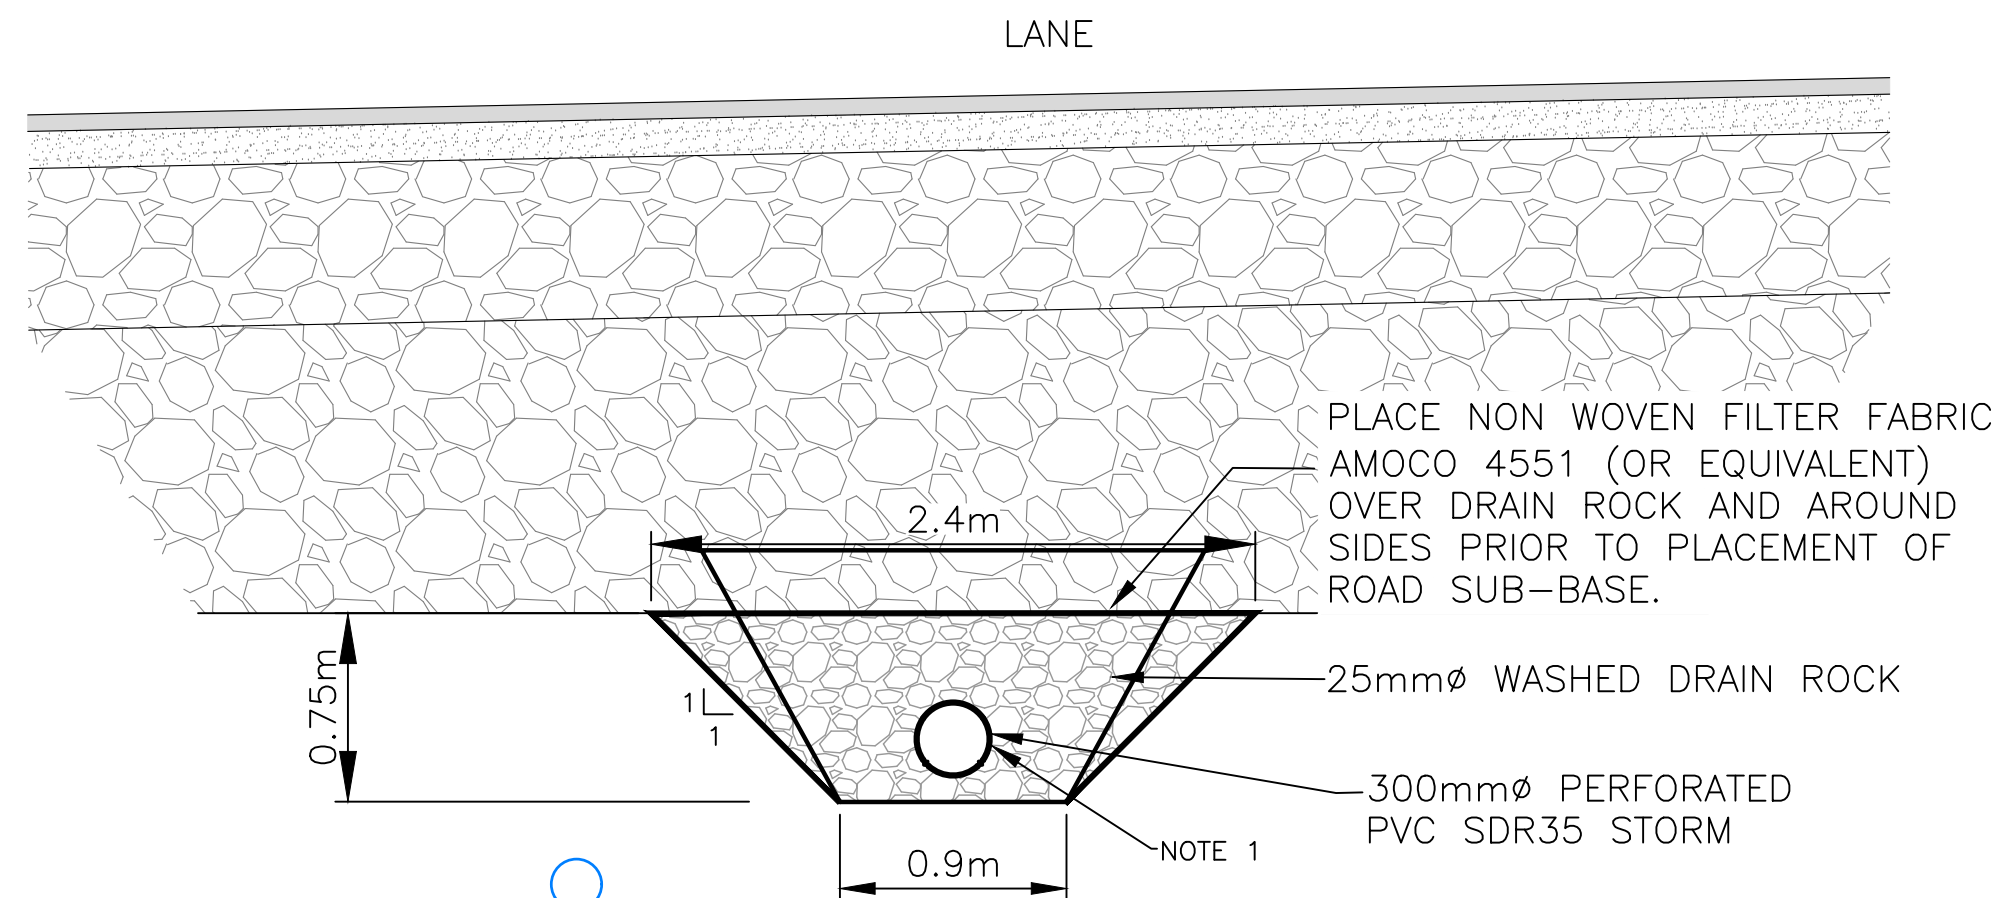


LANE INFILTRATION TRENCH
1:30

NOTE 1:
ALL PERFORATIONS ARE 13mm(1/2") IN DIAMETER. TWO HOLES ARE TO BE MADE AROUND THE PIPE CIRCUMFERENCE AT EACH PERFORATED SECTION WITH HOLES AT APPROXIMATELY THE 4 O'CLOCK, AND 8 O'CLOCK, POSITIONS IN THE SECTION VIEW. PERFORATED SECTIONS SHOULD BE SPACED 150mm (6") O/C APART ALONG THE PIPE.


PERFORATED STORM MAIN
1:10

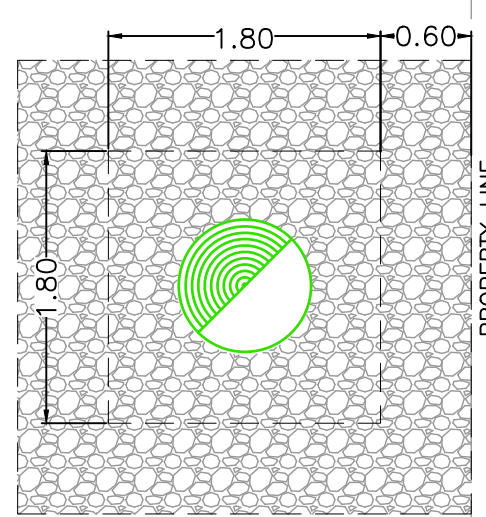

SECTION

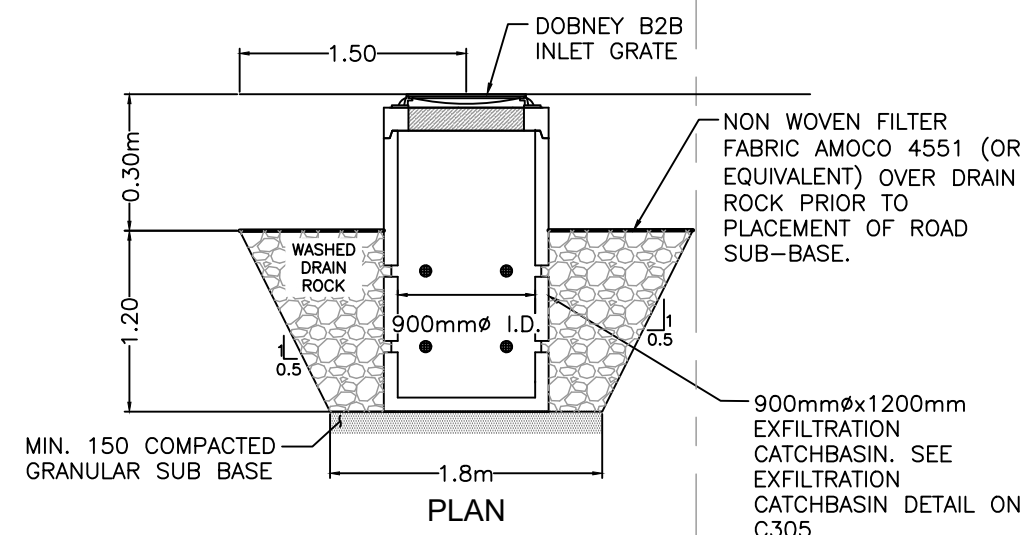

LAWN DRAIN ROCK PIT
N.T.S.

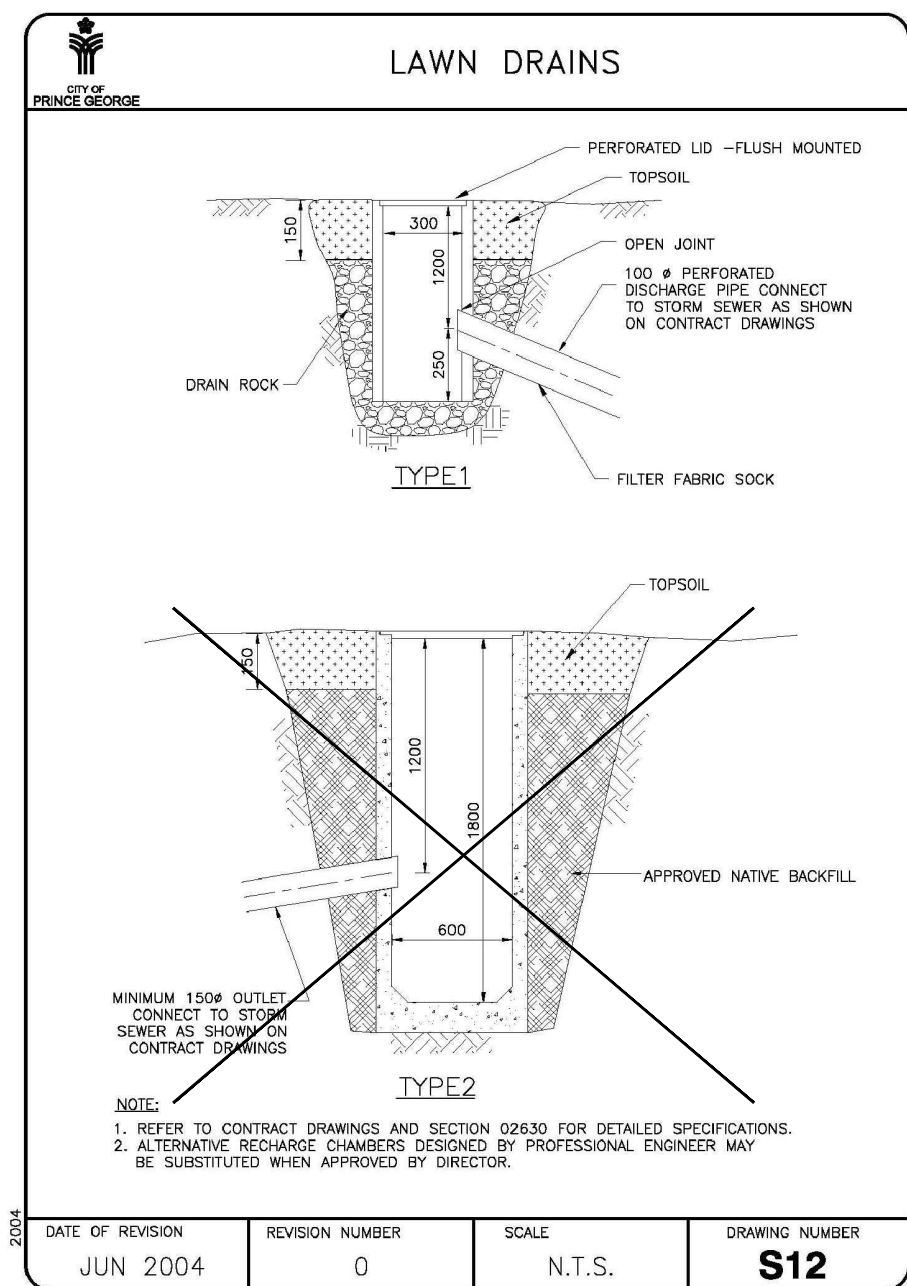


NOTE:
1. REFER TO CONTRACT DRAWINGS AND SECTION 02630 FOR DETAILED SPECIFICATIONS.
2. ALTERNATIVE RECHARGE CHAMBERS DESIGNED BY PROFESSIONAL ENGINEER MAY BE SUBSTITUTED WHEN APPROVED BY DIRECTOR.


DATE OF REVISION	REVISION NUMBER	SCALE	DRAWING NUMBER
JUN 2004	0	N.T.S.	S12




FULL PAVEMENT STRUCTURE DETAIL
1:20

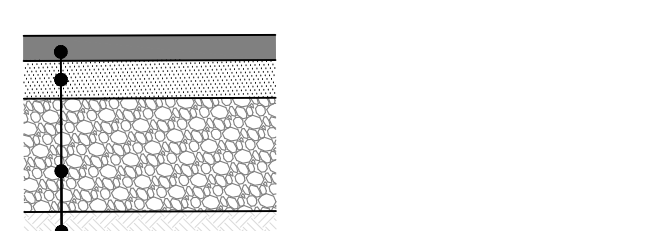


SIDEWALK STRUCTURE DETAIL
1:20

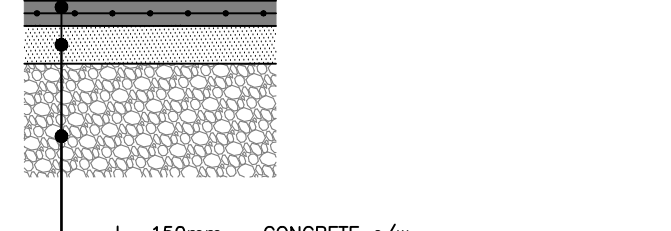

CONCRETE APRON STRUCTURE DETAIL
1:20

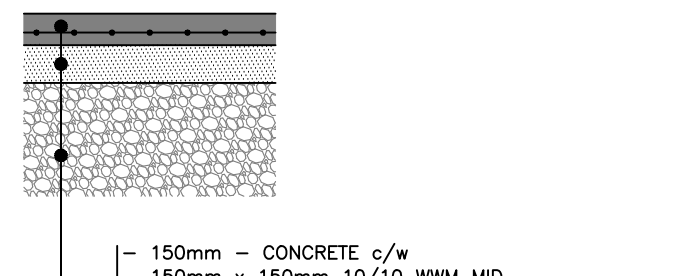

GARBAGE SLAB STRUCTURE DETAIL
1:20

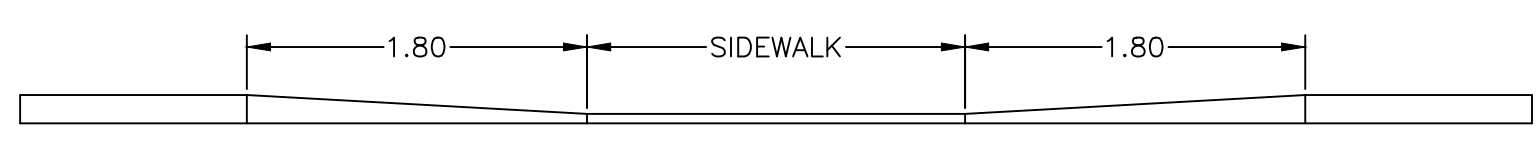

SIDEWALK CURB DROP
1:40

RECORD DRAWING