



City of Prince George  
**History Sheet**

PID:	030878616
SD/MU:	
WO:	

Civic Address: 2820 15th Ave  
2880 15th Ave

Legal Description: Lot: 2 District Lot: 1429 Plan: EPP72370


Service Type	Diameter (mm)	Material	Invert Elev at main (m)	Invert Elev at property line (m)	Invert Elev at service end (m)	Distance into property (m)	Installation Date
Sanitary	200mm	AC	-	-	-	-	January 1975
Water (W1)	50mm	Copper	-	-	-	-	January 1960
Water (W2)	50mm	Copper	-	-	-	-	January 1960
Water (W3)	50mm	Copper	-	-	-	-	January 1960
Storm	200mm	Vit	-	-	-	-	January 1973

Service Connection Location	Sanitary (m)	Storm (m)
200mm Sanitary service connected to San MH 729	-	
250mm Storm service connected to Stm MH 1929		

Power	Size	Communications	Size	Cable	Size	Gas	Size
BC Hydro	-	Telus	-	Shaw	-	FortisBC	-
Overhead Service		Overhead Service		Overhead Service			

Installed by:	Survey Date:	-
Comments: Confirmed by UTOPS - December 2016		

**NOT TO SCALE** The information contained herein is for internal use only.  
Not to be relied on unless confirmed by site inspection and/or investigation.

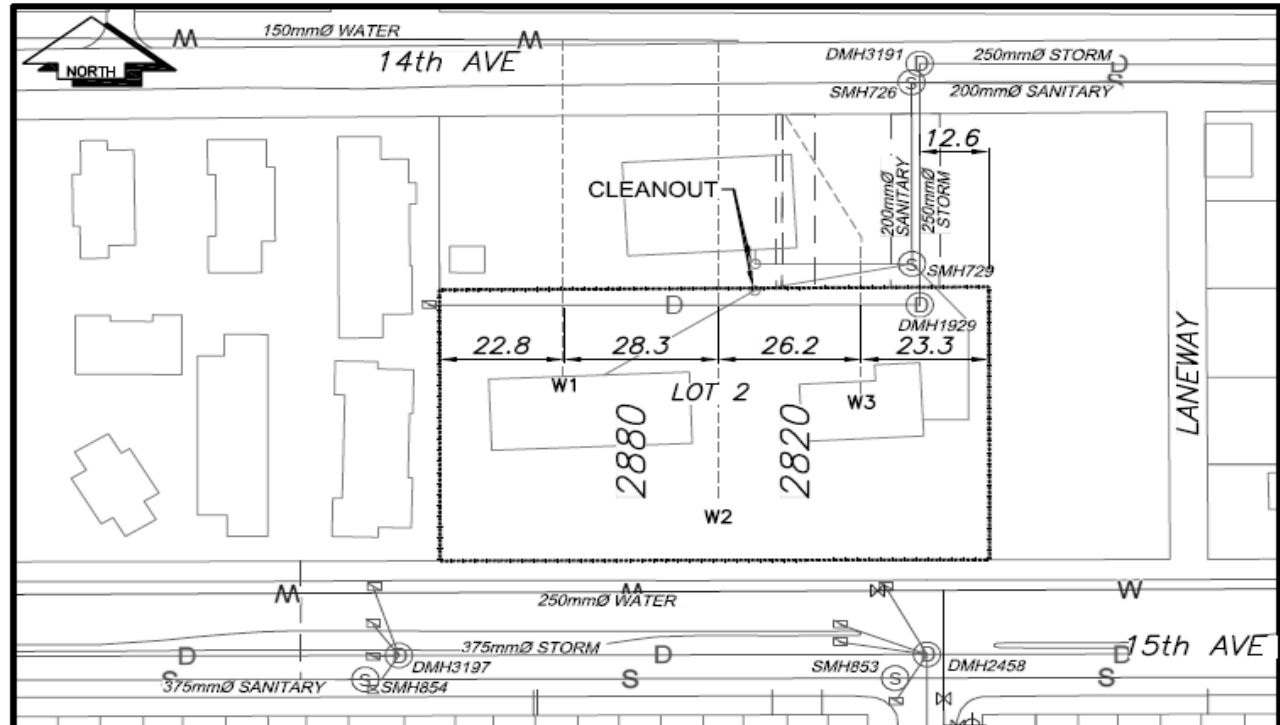

CS CURB STOP	WATER SERVICE	STORM SERVICE
CO CLEAN OUT	SANITARY SERVICE	GAS
WATER VALVE	FIRE HYDRANT	ENCUMBERANCE

**NOT TO SCALE**